

**SURVEY &  
REMONUMENTATION**

**OCT 19 1998**

**LAND CORNER RECORDATION CERTIFICATE  
Filing Requirement of Act 74, Mich. P.A. 1970**

For corners in **SECTION**

<u>Charlevoix</u> (County)	Located In:	Corner Code #
1. Public Land Survey	T <u>32</u> N R <u>7</u> W	<u>F-13</u>
	T <u>31</u> N R <u>7</u> W	<u>F-1 ANTRIM</u>
2. Property Controlling in Section	S <u>    </u> T <u>    </u> R <u>    </u>	<u>    </u>
3. Miscellaneous Property in Sec.	S <u>    </u> T <u>    </u> R <u>    </u>	<u>    </u>

STATE OF MICHIGAN  
COUNTY OF CHARLEVOIX  
RECEIVED

98 SEP -8 PM 2:08

*Charlotte M. Coakley*  
REGISTER OF DEEDS

Register of Deeds Stamp & File Number

4. Lot No. \_\_\_\_\_, Recorded Plat \_\_\_\_\_  
5. Private Claims \_\_\_\_\_

Wayne E. Boss June 98  
I, \_\_\_\_\_, in a field survey on \_\_\_\_\_, 19\_\_\_\_ do hereby state that under requirements of P.A. 74, Michigan P.A. of 1970, the corner points mentioned in lines 1 and 2 above were in conformance with regulations and rules therefore as required in the current manual of survey instructions of the United States Department of the Interior, Bureau of Land Management or by a decree of a Court of Law and for that the corner points mentioned in lines 3, 4 and 5 above were in conformance with the rules of the Michigan Board of Land Surveyors or by a Decree of a Court of Law; established, re-established, monumented, recovered, found as expressed below:

NOTE: Not more than 2 corners, all in the same town and range, may be recorded on this certificate.

A	B	C	D	E	F	G	H	I	J	K	L	M
1												
2	6	5	4	3	2	1						
3												
4	7	8	9	10	11	12						
5												
6	18	17	16	15	14	13						
7												
8	19	20	21	22	23	24						
9												
10	30	29	28	27	26	25						
11												
12	31	32	33	34	35	36						
13												

A. Description of original monument and accessories and/or subsequent restoration:

F-13

OCTOBER 1856, EDWARD D. ATWATER, DEPUTY SURVEYOR  
NO OLD CORNER FOUND, SET QUARTER CORNER  
SUGAR 5 INCH N61°E 20 LINKS  
SUGAR 16 INCH S21°W 39 LINKS

B. Description of corner evidence found and/or method applied in restoring or reestablishing corner:

F-13

APRIL 1998, NO EVIDENCE OF OLD CORNER OR WITNESSES FOUND  
REESTABLISHED QUARTER CORNER AS MID POINT ON LINE BETWEEN ADJACENT SECTION CORNERS


GLO RECORD INDICATES QUARTER CORNER WAS PLACED 40 CHAINS WEST OF SECTION CORNER AND 40 CHAINS EAST OF SOUTHWEST SECTION CORNER  
G-13 TO F-13 GLO 40 CHAINS (2640.0') MEASURES 2628.00'  
F-13 TO E-13 GLO 40 CHAINS (2640.0') MEASURES 2628.00'

Charlevoix Co. Surveyor  
**APPROVED**  
Signature *Mary C. Ferrett*  
Date: *Aug. 13, 1998*

C. Description of monument for corner and accessories established to perpetuate locating the position of the corner:

F-13

PLACED CONCRETE CHARLEVOIX COUNTY MARKER IN CENTER OF EAST WEST TWO TRACK ROAD  
ALSO, AN OLD FENCE ROW EXTENDS SOUTH IN LINE WITH NEW CORNER  
6" ELM N39° 13.54' SET NAIL & TAG  
TWIN 12" MAPLE S76°E 157.81' SET NAIL & TAG  
12" APPLE SOUTH 27.01' SET NAIL & TAG  
6" ELM N77°W 50.13' SET NAIL & TAG

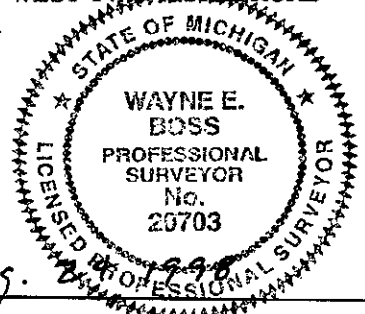

Signed by *Wayne E. Boss*  
Surveyor's Michigan License No. 20703

Date Aug. 13, 1998