

SURVEY & REMONUMENTATION

OCT 19 1998

LAND CORNER RECORDATION CERTIFICATE
Filing Requirement of Act 74, Mich. P.A. 1970

STATE OF MICHIGAN
COUNTY OF CHARLEVOIX
RECEIVED

98 SEP -8 PM 2:09

Charlotte M. Fisher
REGISTER OF DEEDS

Register of Deeds Stamp & File Number

SECTION

For corners in

Charlevoix

(County)

Located In:

Corner Code #

1. Public Land Survey

T 32N R 7W H-13
T 31N R 7W H-1 ANTRIM

2. Property Controlling in Section

S T R
S T R

3. Miscellaneous Property in Sec.

S T R
S T R

4. Lot No. _____, Recorded Plat _____

5. Private Claims _____

Wayne E. Boss

June 98

I, _____, in a field survey on _____, 19____ do hereby state that under requirements of P.A. 74, Michigan P.A. of 1970, the corner points mentioned in lines 1 and 2 above were in conformance with regulations and rules therefore as required in the current manual of survey instructions of the United States Department of the Interior, Bureau of Land Management or by a decree of a Court of Law and /or that the corner points mentioned in lines 3, 4 and 5 above were in conformance with the rules of the Michigan Board of Land Surveyors or by a Decree of a Court of Law; established, re-established, monumented, recovered, found as expressed below:

NOTE: Not more than 2 corners, all in the same town and range, may be recorded on this certificate.

	A	B	C	D	E	F	G	H	I	J	K	L	M
1													
2	6		5		4		3		2		1		
3													
4	7		8		9		10		11		12		
5													
6	18		17		16		15		14		13		
7													
8	19		20		21		22		23		24		
9													
10	30		29		28		27		26		25		
11													
12	31		32		33		34		35		36		
13													

A. Description of original monument and accessories and/or subsequent restoration:

H-13 OCT. 1856, ED. D. ATWATER, DEPUTY SURVEYOR BEFORE NOV. 18, 1892
NO OLD CORNER FOUND, SET 1/4 POST E.K. ROBINSON, COUNTY SURVEYOR
(1 BEECH 5 INCH N50*W 39 LINKS FOUND POST 39.72 CHNS. E. OF SEC. POST
(2 BEECH 7 INCH S36*E 15 LINKS (1 BEECH 5" N50*W 39 LINKS
(2 BEECH 7" S36*E 18 LINKS
MEASURED 39.75 CHAINS TO SE SECTION CORNER
June 19, 1978 LAWRENCE R. FEINDT, P.S. NO OLD CORNER FOUND, PLACED CHAR. CO. ALUMINIUM
MARKER AT RECORD DISTANCE FROM SW SEC. CORNER, DISTANCE CHECKED TO SE SEC. CORNER
(3 15" MAPLE WEST 15.55'. (4 3" MAPLE N60*W 16.50'. (5 18" BEECH N35*E 15.70'. (6 6" MAPLE S30*E 28.90'


B. Description of corner evidence found and/or method applied in restoring or reestablishing corner:

H-13 APRIL 24, 1998 FOUND 1" ALUMINIUM SHAFT WITH MAGNETIC CAP CHARLEVOIX COUNTY MARKER
(3 15" MAPLE WEST 15.55'
(4 3" MAPLE N60*W 16.50'
(5 18" BEECH STUMP N35*E 15.70'
(6 6" MAPLE S30*E 28.90' NO NAIL FOUND
(7 18" HEMLOCK N60*E 20.75' ARTHUR RANGER TAG IN W. FACE
(8 4" MAPLE SOUTH 9.42' ARTHUR RANGER TAG IN N. FACE
I-13 TO H-13 GLO 40 CHAINS (2640.0') E.K.ROBINSON 39.75 CHAINS (2623.5') MEASURES 2599.35'
H-13 TO G-13 GLO 40 CHAINS (2640.0') E.K.ROBINSON 39.72 CHAINS (2621.52') MEASURES 2600.46'

Charlevoix Co. Surveyor
APPROVED
Signature Mary C Feindt
Date: Aug 13 1998

C. Description of monument for corner and accessories established to perpetuate locating the position of the corner:

H-13 CHARLEVOIX COUNTY MARKER REMAINS IN PLACE AS FOUND
16" MAPLE WEST 15.55'
4" MAPLE N60*W 16.50'
6" MAPLE S30*E 28.90'
18" HEMLOCK N60*E 20.75' A. RANGER CAP WEST FACE
4" MAPLE SOUTH 9.42' A. RANGER CAP N.FACE

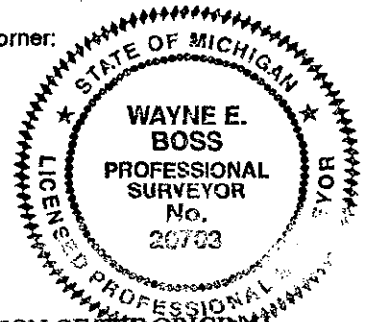

AND IS ACCEPTED AS A CAREFUL & FAITHFUL REESTABLISHMENT OF THE POSITION OF THE ORIGINAL CORNER

Signed by *Wayne E. Boss*
Surveyor's Michigan License No. 20703

Date Aug. 24, 1998