

99 NOV 11 PM 3:00

LAND CORNER RECORDATION CERTIFICATE  
 Filing Requirement of Act 74, Mich. P.A. 1970

*Cherene M. Jentzen*

For corners in

Charlevoix  
 (County)

Located in:

Corner Code #

1. Public Land Survey

T 32 R 7W M-2 ✓  
 T 32 R 6W A-2  
 T     R          
 T     R          
 S     T     R          
 S     T     R          
 S     T     R          
 S     T     R        

2. Property Controlling  
 in Section

3. Miscellaneous  
 Property in Sec.

4. Lot No. \_\_\_\_\_, Recorded Plat \_\_\_\_\_  
 5. Private Claims \_\_\_\_\_

REGISTER OF DEEDS

RECORDED

FEB 11 2000

SECTION

Register of Deeds Stamp & File Number

I, Wayne E. Boss, in a field survey on OCTOBER 23, 1996 do hereby state that under requirements of P.A. 74, Michigan P.A. of 1970, the corner points mentioned in lines 1 and 2 above were in conformance with regulations and rules therefore as required in the current manual of survey instructions of the United States Department of the Interior, Bureau of Land Management or by a decree of a Court of Law and for that the corner points mentioned in lines 3, 4 and 5 above were in conformance with the rules of the Michigan Board of Land Surveyors or by a Decree of a Court of Law; established, re-established, monumented, recovered, found as expressed below:

NOTE: Not more than 2 corners, all in the same town and range, may be recorded on this certificate.

	A	B	C	D	E	F	G	H	I	J	K	L	M
1													
2		6		5		4		3		2		1	
3													
4		7		0		9		10		11		12	
5													
6		10		17		16		15		14		13	
7													
8		19		20		21		22		23		24	
9													
10		30		29		28		27		26		25	
11													
12		31		32		33		34		35		36	
13													

A. Description of original monument and accessories and/or subsequent restoration:  
 M-2 GLO SEPT. 1856  
 E.D. ATWATER  
 QR. SEC. CORNER  
 1. BEECH 8 N71 1/4 E 36 LKS.  
 2. BEECH 6 S 62 1/4 W 25 LKS.  
 E.K. ROBINSON USED IN JUNE  
 1886 SURVEY. NO NEW WIT  
 (BOOK 43).  
 S. CHAMBERLAIN SET CHX.  
 CO. MARKER FEB. 1983  
 LCRC L.2 P.163 BY SINGLE  
 PRORATION FROM SECTION  
 CORNERS.  
 3. N40E 17.45' 12" MAPLE  
 4. N74W 14.40' 5" MAPLE  
 5. S05E 16.80' 9" MAPLE  
 6. S82E 8.48' 6" MAPLE


7. NORTH 33' +/- C/L OF TRAIL

B. Description of corner evidence found and/or method applied in restoring or reestablishing corner:  
 M-2 FOUND CHARLEVOIX CO. MARKER  
 3. N40E 17.45' 14" MAPLE  
 4. N74W 14.38' 8" ASH  
 5. S05E 16.83' 12" MAPLE  
 6. S82E 8.51' 8" MAPLE  
 7. NORTH 33' +/- C/L OF ROAD

Charlevoix Co. Surveyor  
**APPROVED**  
 Signature Mary C. Fernick  
 Date: Oct. 21, 1999

C. Description of monument for corner and accessories established to perpetuate locating the position of the corner:

M-2 & A-2 M-2 T32N-R7W COMMON CORNER TO A-2 T32N-R6W  
 CHARLEVOIX CO. MARKER FOUND.  
 3. N40E 17.45' 14" MAPLE NEW SPIKE & TAGS SET  
 4. N74W 14.38' 8" ASH NEW SPIKE & TAGS SET  
 5. S05E 16.83' 12" MAPLE NEW SPIKE & TAGS SET  
 6. S82E 8.51' 8" MAPLE  
 7. NORTH 33' +/- C/L OF ROAD  
 AND IS ACCEPTED AS A CAREFUL & FAITHFUL REESTABLISHMENT OF THE POSITION OF THE ORIGINAL CORNER.

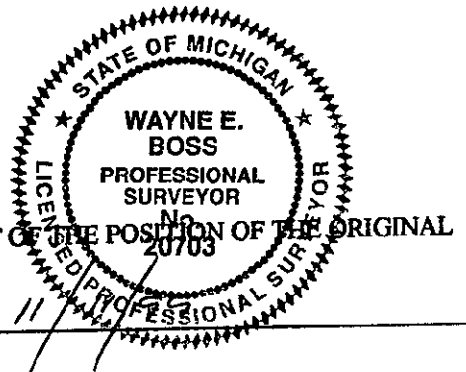

Signed by *Wayne E. Boss*  
 Surveyor's Michigan License No. 20703

Date 11