SURVEY & REMONUMENTATION

JAN 2 6 1998

SECTION

STATE OF MICHIGAN
COUNTY OF CHARLEVOIX
RECEIVED FOR RECORD

97 DEC 15 PM 2:51

Charlene M. Crocker
REGISTER OF DEEDS

LAND CORNER RECORDATION CERTIFICATE
Filing Requirement of Act 74, Mich. P.A. 1970

For corners in Charlevoix (County)

	Located In:	Corner Code #
1. Public Land Survey	T32N R 7W	M-8
	T___ R___	
	T32N R 6W	A-8
	T___ R___	
2. Property Controlling	S___ T___ R___	
in Section	S___ T___ R___	
3. Miscellaneous	S___ T___ R___	
Property in Sec.	S___ T___ R___	

Register of Deeds Stamp & File Number

4. Lot No. _____ , Recorded Plat _____
5. Private Claims _____

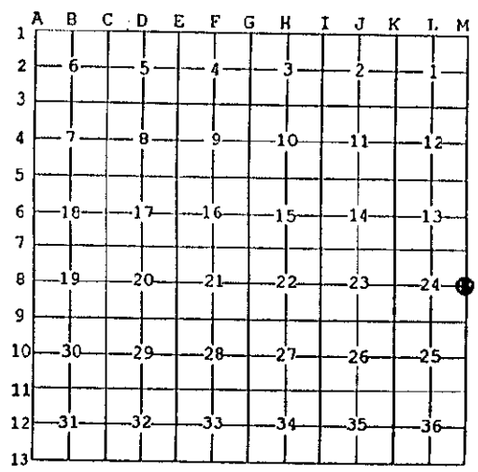

I, Wayne E. Boss, in a field survey on May 97, 19 ___ do hereby state that under requirements of P.A. 74, Michigan P.A. of 1970, the corner points mentioned in lines 1 and 2 above were in conformance with regulations and rules therefore as required in the current manual of survey instructions of the United States Department of the Interior, Bureau of Land Management or by a decree of a Court of Law and /or that the corner points mentioned in lines 3, 4 and 5 above were in conformance with the rules of the Michigan Board of Land Surveyors or by a Decree of a Court of Law; established, re-established, monumented, recovered, found as expressed below:

NOTE: Not more than 2 corners, all in the same town and range, may be recorded on this certificate.

A. Description of original monument and accessories and/or subsequent restoration:

M-8 OCTOBER 1856
E.D. ATWATER, DEPUTY SURVEYOR
SET POST
1. BEECH 11 INCH N85E 33 LKS.
2. BEECH 8 INCH S78W 37 LKS.
DECEMBER 1982, SHERMAN A. CHAMBERLAIN
3. 11" MAPLE N80W 9.33' 4. 2" HEMLOCK N50W 3.80'
5. 4" IRONWOOD EAST 11.73' 6. 3" MAPLE S40W 15.25'

1886
E.K. ROBINSON
FOUND WITNESSES

SEPTEMBER 24, 1981
LAWRENCE R. FEINDT
FD STL SPK AT FNC LINE INTERSEC. E,W &S.
SET CHARLEVOIX COUNTY MARKER
3. 11" MAPLE N80W 9.23'
4. 2" HEMLOCK N50W 3.80'
5. 4" IRONWOOD EAST 11.73'
6. 3" MAPLE S40W 15.25'

B. Description of corner evidence found and/or method applied in restoring or reestablishing corner:

M-8 NOVEMBER 1996
FOUND CHARLEVOIX COUNTY MARKER 1" ALUMINUM SHAFT WITH MAGNETIC CAP
3. 11" MAPLE N80W 9.33'
4. 2" HEMLOCK N50W 9.33'
5. 4" IRONWOOD EAST 11.73'
6. 3" MAPLE S40W 15.25'

Charlevoix Co. Surveyor
APPROVED
Signature Mary C. Feindt
Date: 11-13-97

STATE OF MICHIGAN
WAYNE E. BOSS
PROFESSIONAL SURVEYOR
No. 20703
LICENSED PROFESSIONAL SURVEYOR

C. Description of monument for corner and accessories established to perpetuate locating the position of the corner:

M-8 CHARLEVOIX COUNTY MARKER AS FOUND
3. 11" MAPLE N80W 9.33'
4. 2" HEMLOCK N50W 3.80'
5. 4" IRONWOOD EAST 11.73'
6. 3" MAPLE S40W 15.25'
AND IS ACCEPTED AS A CAREFUL & FAITHFUL REESTABLISHMENT OF THE POSITION OF THE ORIGINAL CORNER.

Signed by _____ Date 12/12/97
Surveyor's Michigan License No. 20703

LIBER 003 PAGE 134

FORM APPROVED BY MICHIGAN STATE BOARD OF PROFESSIONAL SURVEYORS, JAN. 28, 1971
REVISED MAY 14, 1975