

JAN 26 1998

SECTION

LAND CORNER RECORDATION CERTIFICATE
Filing Requirement of Act 74, Mich. P.A. 1970

STATE OF MICHIGAN
COUNTY OF CHARLEVOIX
RECEIVED FOR RECORD

97 DEC 15 PM 2: 52

Charles M. Coaker
REGISTER OF DEEDS

For corners in

Charlevoix

(County)

Located In:

Corner Code #

1. Public Land Survey

T 32N R 7W

M-9

T R

T 32N R 6W

A-9

T R

2. Property Controlling
In Section

S T R

S T R

3. Miscellaneous
Property in Sec.

S T R

S T R

Register of Deeds Stamp & File Number

4. Lot No. _____, Recorded Plat _____
5. Private Claims _____

Wayne E. Boss

May 97

in a field survey on _____, 19____ do hereby state that under
requirements of P.A. 74, Michigan P.A. of 1970, the corner points mentioned in lines 1 and 2 above were in
conformance with regulations and rules therefore as required in the current manual of survey instructions of the
United States Department of the Interior, Bureau of Land Management or by a decree of a Court of Law and /or
that the corner points mentioned in lines 3, 4 and 5 above were in conformance with the rules of the Michigan
Board of Land Surveyors or by a Decree of a Court of Law; established, re-established, monumented,
recovered, found as expressed below:

NOTE: Not more than 2 corners, all in the same town and range, may be recorded
on this certificate.

	A	B	C	D	E	F	G	H	I	J	K	L	M
1													
2	6		5		4		3		2		1		
3													
4	7		8		9		10		11		12		
5													
6	18		17		16		15		14		13		
7													
8	19		20		21		22		23		24		
9													
10	30		29		28		27		26		25		
11													
12	31		32		33		34		35		36		
13													

A. Description of original monument and accessories and/or subsequent restoration:

M-9 OCT. 1856

E.D. ATWATER, DEPUTY SURVEYOR
SET POST

1. BEECH 12 INCH N10 1/2W 17 LKS.
2. BEECH 12 INCH S20W 10 LKS.

JANUARY 1958

THOMAS E. SCHWEIGART, R.L.S.

USED FOUR WAY FENCE INTERSECTION
NO WITNESSES NOTED

DECEMBER 1982

SHERMAN A. CHAMBERLAIN

SET 5/8" IRON AT FENCE
INTERSECTION PER T.E.S.
3. 10" BEECH N10E 25.55'
4. 10" TRIPPLE MAPLE N86E 13.71'
5. 5" MAPLE S43E 12.00'
6. 4" HEMLOCK N87W 15.92'

B. Description of corner evidence found and/or method applied in restoring or reestablishing corner:

M-9 NOV. 1996

FOUND 5/8" ROD WITH CAP 21566 & 25834

3. 10" BEECH N10E 25.55'
4. 10" TRIPPLE MAPLE N86E 13.71'
5. 5" MAPLE S43E 12.00'
6. 4" HEMLOCK N87W 15.92'

Charlevoix Co. Surveyor

APPROVED

Signature *Mary C. Feindel*

Date: *11.13.97*


C. Description of monument for corner and accessories established to perpetuate locating the position of the corner:

M-9

5/8" ROD REPLACED WITH CONCRETE CHARLEVOIX COUNTY MONUMENT

3. 10" BEECH N10E 25.55'
4. 10" TRIPPLE MAPLE N86E 13.71'
5. 5" MAPLE S43E 12.00'
6. 4" HEMLOCK N87W 15.92'

AND IS ACCEPTED AS A CAREFUL & FAITHFUL REESTABLISHMENT OF THE POSITION OF THE ORIGINAL
CORNER

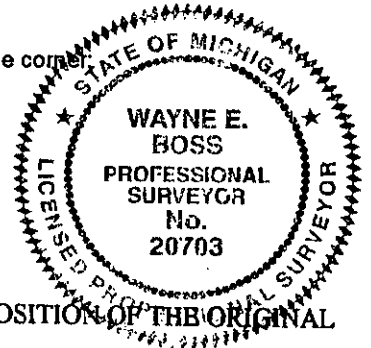

Signed by _____
Surveyor's Michigan License No. 20703

Date 12/12/97