

SURVEY & REMONUMENTATION

JAN 26 1998

STATE OF MICHIGAN
COUNTY OF CHARLEVOIX
RECEIVED FOR RECORD

97 DEC 15 PM 2:53

SECTION

LAND CORNER RECORDATION CERTIFICATE
Filing Requirement of Act 74, Mich. P.A. 1970

Charles M. Cooker
REGISTER OF DEEDS

For corners in

Charlevoix

Located In:

Corner Code #

(County)

1. Public Land Survey

T 32NR 7W

M-10

T R

T 32NR 6W

A-10

T R

2. Property Controlling in Section

S T R

S T R

3. Miscellaneous Property in Sec.

S T R

S T R

Register of Deeds Stamp & File Number

4. Lot No. _____, Recorded Plat _____

5. Private Claims _____

Wayne E. Boss

May 1997

I, _____, in a field survey on _____, 19____ do hereby state that under requirements of P.A. 74, Michigan P.A. of 1970, the corner points mentioned in lines 1 and 2 above were in conformance with regulations and rules therefore as required in the current manual of survey instructions of the United States Department of the Interior, Bureau of Land Management or by a decree of a Court of Law and for that the corner points mentioned in lines 3, 4 and 5 above were in conformance with the rules of the Michigan Board of Land Surveyors or by a Decree of a Court of Law; established, re-established, monumented, recovered, found as expressed below:

NOTE: Not more than 2 corners, all in the same town and range, may be recorded on this certificate.

| | A | B | C | D | E | F | G | H | I | J | K | L | M |
|----|----|---|----|---|----|---|----|---|----|---|----|---|---|
| 1 | | | | | | | | | | | | | |
| 2 | 6 | | 5 | | 4 | | 3 | | 2 | | 1 | | |
| 3 | | | | | | | | | | | | | |
| 4 | 7 | | 8 | | 9 | | 10 | | 11 | | 12 | | |
| 5 | | | | | | | | | | | | | |
| 6 | 18 | | 17 | | 16 | | 15 | | 14 | | 13 | | |
| 7 | | | | | | | | | | | | | |
| 8 | 19 | | 20 | | 21 | | 22 | | 23 | | 24 | | |
| 9 | | | | | | | | | | | | | |
| 10 | 30 | | 29 | | 28 | | 27 | | 26 | | 25 | | |
| 11 | | | | | | | | | | | | | |
| 12 | 31 | | 32 | | 33 | | 34 | | 35 | | 36 | | |
| 13 | | | | | | | | | | | | | |

A. Description of original monument and accessories and/or subsequent restoration:

M-10 OCTOBER 1856

E.D. ATWATER, DEPUTY SURVEYOR SET POST

1. BEECH 6 INCH N52E 13 LKS.

2. LYNN 11 INCH S33W 43 LKS.

NO OLD LINE OR CORNER FOUND

JANUARY 1958

THOMAS F. SCHWEIGART, RLS SET T-IRON BY

PROPORTIONATE MEASUREMENT

3. 16" ELM N70E 47.1'

4. 16" MAPLE N45E 84.4'

SEPTEMBER 1989

NICHOLAS B. DEYOUNG

FOUND T-IRON RAISED WITH 1/2" IR.

4. 24" MAPLE N60E 84.00'

5. 8" PINE S15W 57.80'

6. 20" PINE S30E 134.60'

7. POWER POLE S70E 73.00'

B. Description of corner evidence found and/or method applied in restoring or reestablishing corner:

M-10 NOVEMBER 1996

FD. 1/2" IR. OVER T-IRON

4. 24" MAPLE N60E 85.15'

5. 8" PINE S15W 57.84'

6. FD. STUMP 20" PINE S30E 134.58'

7. POWER POLE S70E 71.01'

8. 6" POPLAR N75W 74.38'

Charlevoix Co. Surveyor

APPROVED

Signature *Mary C. Ferndt*

Date: *11/13/97*

C. Description of monument for corner and accessories established to perpetuate locating the position of the corner:

M-10 1/2" IR & T-IRON REPLACED WITH STEEL CHARLEVOIX COUNTY MARKER


4. 24" MAPLE N60E 85.15' SET NAIL & TAG

5. 8" PINE S15W 57.84'

7. POWER POLE S70E 71.01'

8. 6" POPLAR N75W 74.38' SET NAIL & TAG

AND IS ACCEPTED AS A CAREFUL REESTABLISHMENT OF THE POSITION OF THE ORIGINAL CORNER

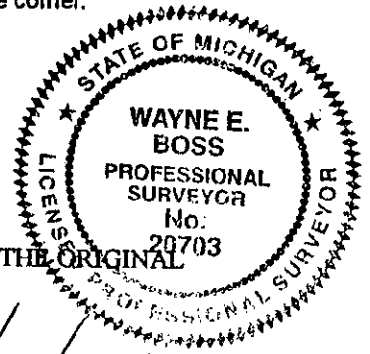

Signed by _____
Surveyor's Michigan License No. 20703

Date 12/12/97