


MEANDER CORNER DESIGNATION FOR REMONUMENTATION PROGRAM

Town 32 North Range 7 West

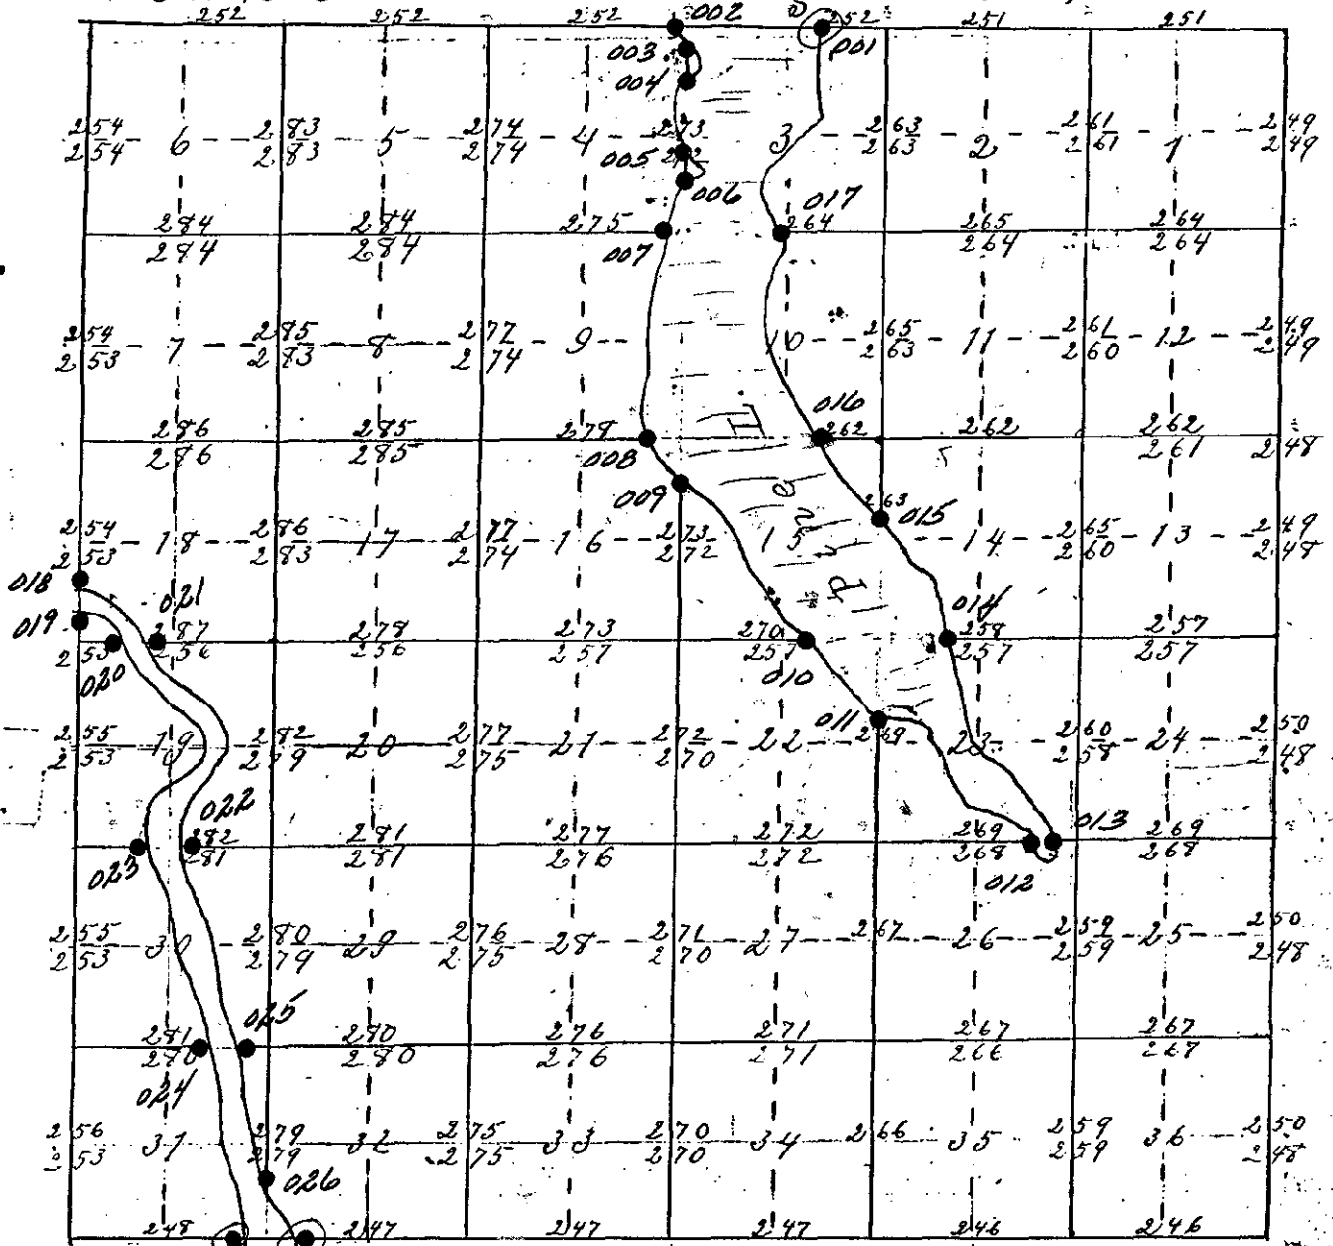

L3 PG. 189 028 027 L3 PG. 188
 Meander Lines on Pages 287 to 293 inclusive
 Random Lines in Red

SURVEY & REMONUMENTATION

JAN 11 1999

SECTION

SOUTH ARM TOWNSHIP