

99 NOV 11 PM 2:59

LAND CORNER RECORDATION CERTIFICATE  
 Filing Requirement of Act 74, Mich. P.A. 1970

*Charlene M. Jantroy*

REGISTER OF DEEDS

For corners in

Charlevoix

(County)

Located In:

Corner Code #

1. Public Land Survey

T 32N 6W A-2 ✓  
 T 32N 7W M-2

2. Property Controlling in Section

S \_\_\_\_\_ T \_\_\_\_\_ R \_\_\_\_\_

3. Miscellaneous Property in Sec.

S \_\_\_\_\_ T \_\_\_\_\_ R \_\_\_\_\_  
 S \_\_\_\_\_ T \_\_\_\_\_ R \_\_\_\_\_

RE

FEB 11 2000

SECTION

Register of Deeds Stamp & File Number

4. Lot No. \_\_\_\_\_, Recorded Plat \_\_\_\_\_  
 5. Private Claims \_\_\_\_\_

I, Wayne E. Boss, in a field survey on OCTOBER 23, 1996 do hereby state that under requirements of P.A. 74, Michigan P.A. of 1970, the corner points mentioned in lines 1 and 2 above were in conformance with regulations and rules therefore as required in the current manual of survey instructions of the United States Department of the Interior, Bureau of Land Management or by a decree of a Court of Law and for that the corner points mentioned in lines 3, 4 and 5 above were in conformance with the rules of the Michigan Board of Land Surveyors or by a Decree of a Court of Law, established, re-established, monumented, recovered, found as expressed below:

NOTE: Not more than 2 corners, all in the same town and range, may be recorded on this certificate.

	A	B	C	D	E	F	G	H	I	J	K	L	M
1													
2	6		5		4		3		2		1		
3													
4	7		8		9		10		11		12		
5													
6	18		17		16		15		14		13		
7													
8	19		20		21		22		23		24		
9													
10	30		29		28		27		26		25		
11													
12	31		32		33		34		35		36		
13													

A. Description of original monument and accessories and/or subsequent restoration:  
 A-2 GLO SEPT. 1856 S. CHAMBERLAIN SET CHX.  
 E.D. ATWATER CO. MARKER FEB. 1983  
 QR. SEC. CORNER LCRC L.2 P.163 BY SINGLE  
 1. BEECH 8 N71 3/4 E 36 LKS. PRORATION FROM SECTION  
 2. BEECH 6 S 62 1/4 W 25 LKS. CORNERS.  
 3. N40E 17.45' 12" MAPLE  
 E.K. ROBINSON USED IN JUNE 4. N74W 14.40' 5" MAPLE  
 1886 SURVEY. NO NEW WIT 5. S05E 16.80' 9" MAPLE  
 (BOOK 43). 6. S82E 8.48' 6" MAPLE


7. NORTH 33' +/- C/L OF TRAIL

B. Description of corner evidence found and/or method applied in restoring or reestablishing corner:  
 A-2 FOUND CHARLEVOIX CO. MARKER  
 3. N40E 17.45' 14" MAPLE  
 4. N74W 14.38' 8" ASH  
 5. S05E 16.83' 12" MAPLE  
 6. S82E 8.51' 8" MAPLE  
 7. NORTH 33' +/- C/L OF ROAD

Charlevoix Co. Surveyor  
**APPROVED**  
 Signature Mary C. Ferndt  
 Date: Oct. 21, 1999

C. Description of monument for corner and accessories established to perpetuate locating the position of the corner:

A-2 & M-2 A-2 T32N-R6W COMMON CORNER TO M-2 T32N-R7W  
 CHARLEVOIX CO. MARKER FOUND.  
 3. N40E 17.45' 14" MAPLE NEW SPIKE & TAGS SET  
 4. N74W 14.38' 8" ASH NEW SPIKE & TAGS SET  
 5. S05E 16.83' 12" MAPLE NEW SPIKE & TAGS SET  
 6. S82E 8.51' 8" MAPLE  
 7. NORTH 33' +/- C/L OF ROAD  
 AND IS ACCEPTED AS A CAREFUL & FAITHFUL REESTABLISHMENT OF THE POSITION OF THE ORIGINAL CORNER.

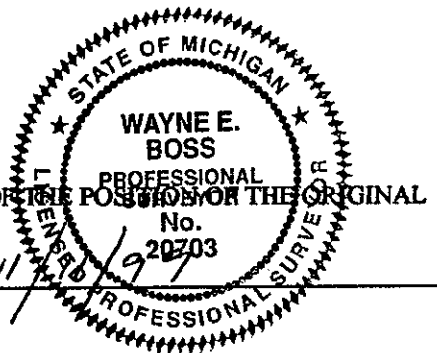

Signed by [Signature]  
 Surveyor's Michigan License No. 20703

Date 11/19/99