

**SURVEY & REMONUMENTATION**

**JAN 26 1998**

**LAND CORNER RECORDATION CERTIFICATE**  
Filing Requirement of Act 74, Mich. P.A. 1970

STATE OF MICHIGAN  
COUNTY OF CHARLEVOIX  
RECEIVED FOR RECORD

97 DEC 16 AM 10:01

*Charles M. Coakley*  
REGISTER OF DEEDS

For corners in SECTION

Charlevoix (County)	Located In:	Corner Code #
1. Public Land Survey	T32N R 6W	A-6
	T R	
	T32N R 7W	M-6
	T R	
2. Property Controlling in Section	S T R	
	S T R	
3. Miscellaneous Property in Sec.	S T R	
	S T R	

Register of Deeds Stamp & File Number

4. Lot No. \_\_\_\_\_, Recorded Plat \_\_\_\_\_  
5. Private Claims \_\_\_\_\_

I, Wayne E. Boss, in a field survey on May, 1997 do hereby state that under requirements of P.A. 74, Michigan P.A. of 1970, the corner points mentioned in lines 1 and 2 above were in conformance with regulations and rules therefore as required in the current manual of survey instructions of the United States Department of the Interior, Bureau of Land Management or by a decree of a Court of Law and/or that the corner points mentioned in lines 3, 4 and 5 above were in conformance with the rules of the Michigan Board of Land Surveyors or by a Decree of a Court of Law; established, re-established, monumented, recovered, found as expressed below:

NOTE: Not more than 2 corners, all in the same town and range, may be recorded on this certificate.

	A	B	C	D	E	F	G	H	I	J	K	L	M
1													
2	6		5		4		3		2		1		
3													
4	7		8		9		10		11		12		
5													
6	18		17		16		15		14		13		
7													
8	19		20		21		22		23		24		
9													
10	30		29		28		27		26		25		
11													
12	31		32		33		34		35		36		
13													

A. Description of original monument and accessories and/or subsequent restoration:

A-6 JUNE 1839 JOHN HODGSON, DEPUTY SURVEYOR SET POST 1. BEECH 14 INCH S81E 24 LKS 2. MAPLE 5 INCH S71W 25 LKS	APRIL 30, 1992 BERYL M. JONES FOUND IRON ORGIN UNKNOWN 3. 12" YELL. BIRCH N82W 11.70' 4. 14" CLUSTER MAPLE N60E 24.65' 5. 20" MAPLE NORTH 18.40' 6. 25" TWIN MAPLE S20E 19.00'	ABOUT 1993 GEORGE J. AVENDT FD. 1/2" IR CAP 23514 REPLACED WITH T-IRON NO WITNESSES LISTED
---	--	--


B. Description of corner evidence found and/or method applied in restoring or reestablishing corner:

A-6 MAY 1997  
FOUND T-IRON & CAP OVER 1 1/4" PIPE  
3. 10" YELLOW BIRCH N77W 11.8'+/- NO NAIL FOUND  
4. 14" MAPLE N62E 24.60 FD. NAIL & CAP 16034  
7. 26" SOFT MAPLE S26E 18.6'+/- FD. NAIL IN E. FACE  
8. 15" MAPLE N4E 19.39' FD. NAIL & CAP 16034

Charlevoix Co. Surveyor  
**APPROVED**  
Signature Mary C. Fennell  
Date: 11-13-97

C. Description of monument for corner and accessories established to perpetuate locating the position of the corner:

A-6 T-IRON AND 1 1/4" PIPE REPLACED WITH CONCRETE CHARLEVOIX COUNTY MONUMENT  
3. 10" YELLOW BIRCH N77W 11.82' SET NAIL & TAG  
4. 14" MAPLE N62E 24.60' NAIL & CAP 16034  
7. 26" SOFT MAPLE S76E 18.64' SET NAIL & TAG IN W.FACE  
8. 15" MAPLE N4E 19.39. NAIL & CAP 16034  
AND IS ACCEPTED AS A CAREFUL & FAITHFUL REESTABLISHMENT OF THE POSITION OF THE ORIGINAL CORNER

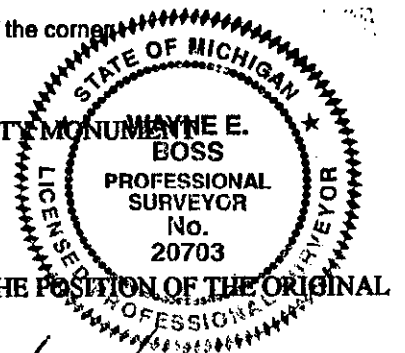

Signed by \_\_\_\_\_  
Surveyor's Michigan License No. 20703

Date 12/16/97