

SURVEY & REMONUMENTATION

JAN 26 1998

SECTION

LAND CORNER RECORDATION CERTIFICATE
Filing Requirement of Act 74, Mich. P.A. 1970

STATE OF MICHIGAN
COUNTY OF CHARLEVOIX
RECEIVED FOR RECORD

97 DEC 16 AM 10:06

Charles B. Conley
REGISTER OF DEEDS

For corners in

<u>Charlevoix</u> (County)	Located In:	Corner Code #
1. Public Land Survey	T <u>32</u> NR <u>6</u> W	<u>A-11</u>
	T ___ R ___	___
	T <u>32</u> NR <u>7</u> W	<u>M-11</u>
	T ___ R ___	___
2. Property Controlling in Section	S ___ T ___ R ___	___
	S ___ T ___ R ___	___
3. Miscellaneous Property in Sec.	S ___ T ___ R ___	___
	S ___ T ___ R ___	___
4. Lot No. _____, Recorded Plat _____		
5. Private Claims _____		

Register of Deeds Stamp & File Number

I, Wayne E. Boss, in a field survey on May, 1997 do hereby state that under requirements of P.A. 74, Michigan P.A. of 1970, the corner points mentioned in lines 1 and 2 above were in conformance with regulations and rules therefore as required in the current manual of survey instructions of the United States Department of the Interior, Bureau of Land Management or by a decree of a Court of Law and /or that the corner points mentioned in lines 3, 4 and 5 above were in conformance with the rules of the Michigan Board of Land Surveyors or by a Decree of a Court of Law; established, re-established, monumented, recovered, found as expressed below:

NOTE: Not more than 2 corners, all in the same town and range, may be recorded on this certificate.

A	B	C	D	E	F	G	H	I	J	K	L	M
1												
2	6	5	4	3	2	1						
3												
4	7	8	9	10	11	12						
5												
6	18	17	16	15	14	13						
7												
8	19	20	21	22	23	24						
9												
10	30	29	28	27	26	25						
11												
12	31	32	33	34	35	36						
13												

A. Description of original monument and accessories and/or subsequent restoration:

- | | | |
|---|---|---|
| A-11 OCTOBER 1856
E.D. ATWATER, DEPUTY SURVEYOR
1. HEMLOCK 11 INCH S71W 19 LKS.
2. SUGAR 9 INCH N53 1/2W 16 LKS.
3. NO OLD CORNER FOUND | JANUARY 1958
THOMAS F. SCHWEIGART, R.L.S
FD. 1" IR IN C.L. M-32
3. POWER POLE S57E 65.4'
4. POWER POLE N75W 90.8'
5. T-IRON NORTH 33.00' | FD. 5/8" IR BURIED 1" UNDER ASPH.
6. 15" MAPLE CLUMP N17W 69.02'
7. 9" MAPLE N40W 71.40'
8. TELEPHONE POLE S65W 65.86'
9. 24" CHERRY S07E 102.79' |
| JUNE 22, 1993 NICHOLAS B. DEYOUNG
10. 6" CLUSTER MAPLE S18E 70.25' | FD. 5/8" IR 3. POWER POLE S53E 65.67' | 6. 8" MAPLE N20W 69.00'
(SEE BACK) |


B. Description of corner evidence found and/or method applied in restoring or reestablishing corner:

Charlevoix Co. Surveyor
APPROVED
Signature *Mary C. Fendt*
Date: 12-13-97

- | | |
|--|---|
| A-11 NOVEMBER 1996
FD. 1/2" X 18" PIPE IN MONUMENT BOX
5. 1/2" IR NORTH 33.00' NO CAP
6. 12' MAPLE CLUMP N17W 69.0'
7. 14" MAPLE N40W 71.0' WITH TAG #14200
9. 32" CHERRY S07E 101.88' WITH TAG 14200
11. POWER POLE N81E 115.83' WITH TAG 20705
12. CHAIN LINK ANCHOR POST S62W 82.05' | 13. CHAIN LINK ANCHOR POST S35W 85.00'
14. 11" RED PINE S60E 99.10' FD. NAIL & CAP 16034
GLO M-11 TO M-12 2640 MEASURE 2633.17'
GLO M-11 TO M-10 2640 MEASURE 2624.69' |
|--|---|

C. Description of monument for corner and accessories established to perpetuate locating the position of the corner:

- | | |
|--|---|
| A-11 1/2" PIPE REPLACED WITH STEEL CHARLEVOIX COUNTY MARKER IN MONUMENT BOX
5. 1/2" IR NORTH 33.00'
6. 12" MAPLE CLUMP N17W 69.0'
7. 14" MAPLE N40W 71.1' WITH TAG 14200
9. 32" CHERRY S07E 101.88' WITH TAG 14200
11. POWER POLE N81E 115.83' WITH TAG 20705
12. CHAIN LINK ANCHOR POST S62W 82.05' | 13. CHAIN LINK ANCHOR POST S35W 85.00'
14. 11" RED PINE S60E 99.10' FD. NAIL & CAP 16034 |
|--|---|

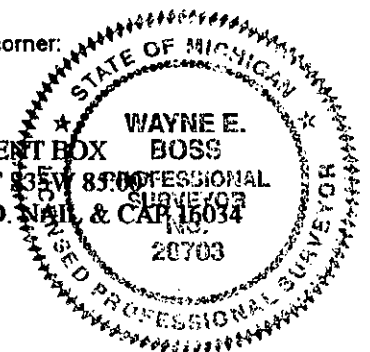

AND IS ACCEPTED AS A CAREFUL & FAITHFUL REESTABLISHMENT OF THE POSITION OF THE ORIGINAL CORNER

Signed by *Wayne E. Boss*
Surveyor's Michigan License No. 20703

Date 12/16/97

**SURVEY &
REMONUMENTATION**

JAN 26 1998

SECTION

1/26/98

- A-11 **APRIL 20, 1994**
JAMES E. EVANS, P.S. 22431
FD. 5/8" IRON IN MONUMENT BOX
5. FD. 1/2" IR NORTH 33.00'
11. POWER POLE N82E 115.83' FD. NAIL & TAG 20705
12. CHN. LNK ANCHOR POST
13. CHN. LNK. ANCHOR POST S35W 85.00'
14. 11" RED PINE S60E 99.10' SET NAIL & TAG 16034