

**SURVEY &
REMONUMENTATION**

JAN 26 1998

SECTION

LAND CORNER RECORDATION CERTIFICATE
Filing Requirement of Act 74, Mich. P.A. 1970

STATE OF MICHIGAN
COUNTY OF CHARLEVOIX
RECEIVED FOR RECORD

97 DEC 16 AM 10:20

Charles M. Coakley
REGISTER OF DEEDS

For corners in

CHARLEVOIX
(County)

Located In:

Corner Code #

1. Public Land Survey

T 32NR 6W

F-1

T R

T R

T R

2. Property Controlling
in Section

S

T R

3. Miscellaneous
Property in Sec.

S

T R

S

T R

4. Lot No. , Recorded Plat

5. Private Claims

Register of Deeds Stamp & File Number

	A	B	C	D	E	F	G	H	I	J	K	L	M
1													
2	6			5		4		3		2		1	
3													
4	7			8		9		10		11		12	
5													
6	18			17		16		15		14		13	
7													
8	19			20		21		22		23		24	
9													
10	30			29		28		27		26		25	
11													
12	31			32		33		34		35		36	
13													

I, ARTHUR R. RANGER, in a field survey on SEPT. 15, 1997
do hereby state that under requirements of P.A. 74, Michigan P.A. of 1970, the corner points mentioned in lines 1 and 2 above were in conformance with regulations and rules therefore as required in the current manual of survey instructions of the United States Department of the Interior, Bureau of Land Management or by a decree of a Court of Law and /or that the corner points mentioned in lines 3, 4 and 5 above were in conformance with the rules of the Michigan Board of Land Surveyors or by a Decree of a Court of Law; established, re-established, monumented, recovered, found as expressed below:

NOTE: Not more than 2 corners, all in the same town and range, may be recorded on this certificate.

A. Description of original monument and accessories and/or subsequent restoration:
F-1 North 1/4 corner to Sec. 4, T.32N., R.6W.
(Not an original GLO corner)
1880-E.K. Robinson set a 1/4 stake and witnessed: Beech 16" S48.25°W 36lks;
Lynn 6" S49.50°E 21lks.
1977-Larry Feindt found a 3/4" iron pipe during his survey in Sec. 4, T.32N., R.6W. And witnessed:
8" Maple N60°W 63.05'; 8" Maple N10°W 34.95'; 5" Maple South 33.30'
1993-Sherm Chamberlain used the corner in his survey of "Trapper Woods" in Sec. 4, T.32N., R.6W.

B. Description of corner evidence found and/or method applied in restoring or reestablishing corner:
F-1 North 1/4 corner to Sec. 4, T.32N., R.6W.
1997-Arthur R. Ranger found a 3/4" I.P. with cap, and witnesses of record; Evidence of old fence to the South.
The corners position fits old Robinson measurements quite well.


C. Description of monument for corner and accessories established to perpetuate locating the position of the corner:
F-1 North 1/4 corner to Sec. 4, T.32N., R.6W.
(Set a Charlevoix County Marker)
Conc. Mon. South 33.00'
6" Elm S26°W 36.60'
8" Maple N50°W 63.30'
12" Maple N37°E 41.00' (slope)

Charlevoix Co. Surveyor
APPROVED
Signature Mary C. Feindt
Date: 12-11-97

THIS POSITION NOT ESTABLISHED BY ORIGINAL GOVERNMENT SURVEY. THIS MONUMENT IS ACCEPTED AS A CAREFUL AND FAITHFUL DETERMINATION OF THE POSITION OF THE CORNER.

Signed by Arthur R. Ranger
Surveyor's Michigan License No. 31601

Date 12/08/97

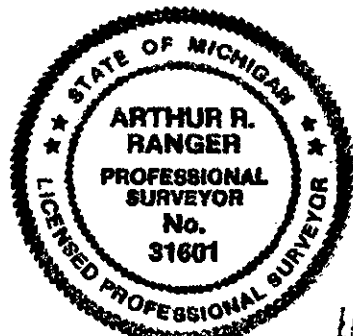

FORM APPROVED BY MICHIGAN STATE BOARD OF PROFESSIONAL SURVEYORS, JAN. 28, 1971
REVISED MAY 14, 1975
REVISED JAN., 1983
REVISED OCT., 1995