

**SURVEY &
RECORD DOCUMENTATION**

OCT 18 1996

COMMISSION

**LAND CORNER RECORDATION CERTIFICATE
Filing Requirement of Act 74, Mich. P.A. 1970**

STATE OF MICHIGAN
COUNTY OF CHARLEVOIX
REGISTERED FOR RECORD

96 OCT 10 AM 11:32

Charlene M. Barber
REGISTER OF DEEDS

For corners in

CHARLEVOIX
(County)

Located In:

Corner Code #

1. Public Land Survey

T 32NR 6W

(I-13)

T 31NR 6W

I-1

T ___ R ___

T ___ R ___

2. Property Controlling
In Section

S ___ T ___ R ___

S ___ T ___ R ___

3. Miscellaneous
Property in Sec.

S ___ T ___ R ___

S ___ T ___ R ___

Register of Deeds Stamp & File Number

4. Lot No. _____, Recorded Plat _____

5. Private Claims _____

I, Arthur R. Ranger, in a field survey on May 18, 1995 do hereby state that under requirements of P.A. 74, Michigan P.A. of 1970, the corner points mentioned in lines 1 and 2 above were in conformance with the regulations and rules therefore as required in the current and survey instructions of the United States Department of the Interior, Bureau of Land Management or by a decree of a Court of Law and/or that the corner points mentioned in lines 3, 4 and 5 above were in conformance with the rules of the Michigan Board of Land Surveyors or by a Decree of a Court of Law; established, re-established, monumented, recovered, found as expressed below:

NOTE: Not more than 2 corners, all in the same town and range, may be recorded on this certificate.

	A	B	C	D	E	F	G	H	I	J	K	L	M
1													
2	6		5		4		3		2		1		
3													
4	7		8		9		10		11		12		
5													
6	18		17		16		15		14		13		
7													
8	19		20		21		22		23		24		
9													
10	30		29		28		27		26		25		
11													
12	31		32		33		34		35		36		
13													

A. Description of original monument and accessories and/or subsequent restoration:

I-13 corner common to Sections 34 & 35, T.32N-R.6W & I-1 Sections 2 & 3, T.31N-R.6W

1856- E.D. Atwater set a new Sec. Corner in his Resurvey and witnessed: Sugar 12" N42.75°E 63 lks.; Elm 10" N31°W 33 lks.; (Old corner 174 lks. North and 160 lks. East).

1903- E.A. Robinson, surveyor found the corner and set new witnesses: Sugar 12" N42.75°E 63 lks.; Elm 10" N31°W 33 lks.; Lynn 10" N36.3°W 43 lks.

1971- Larry Cavanagh, Surveyor found a 1/2" Iron bar and witnessed: 4" Maple S25°W 18.7'; 5" Maple S65°E 27.7'.

B. Description of corner evidence found and/or method applied in restoring or reestablishing corner:

I-13 corner common to Sections 34 & 35, T.32N-R.6W & I-1 Sections 2 & 3, T.31N-R.6W

1995- Arthur R. Ranger, surveyor found the Ferguson witnesses and the prior witnesses; No iron stake was found; A hole was dug with the witnesses and a piece of the lathe was found. (No iron stake). The location of the hole based on the witnesses fits an Old E.A. Robinson distance to the East to Marvon Road by 1'; Also the hole location fits a line between stakes to the West. The location also fits the GLO distance to the South by 3'.


C. Description of monument for corner and accessories established to perpetuate locating the position of the corner:

I-13 corner common to Sections 34 & 35, T.32N-R.6W & I-1 Sections 2 & 3, T.31N-R.6W

Set a Harrison monument based on the record witnesses.

6" Apple N46°W 33.94'
Black Ash (10"tri) S77°W 49.62'
4" Maple S12°W 19.71'
4" Maple S58°E 32.75'

Charlevoix Co. Surveyor
APPROVED
Signature Mary C. Feendt
Date October 10, 1996

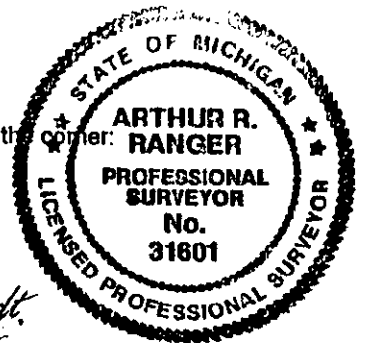

The location of the hole based on the witnesses is accepted as a careful and faithful reestablishment of the position of the original corner.

Signed by Arthur R. Ranger

Date 10/09/96

Surveyor's Michigan License No. 31601