

REMONUMENTATION

NOV 2 1 1997

COMMISSION

LAND CORNER RECORDATION CERTIFICATE
Filing Requirement of Act 74, Mich. P.A. 1970

STATE OF MICHIGAN
COUNTY OF CHARLEVOIX
RECEIVED FOR RECORD

97 OCT 31 PM 3:14

REGISTER OF DEEDS

For corners in

Table with columns: CHARLEVOIX (County), Located In, Corner Code #. Includes entries for Public Land Survey, Property Controlling in Section, and Miscellaneous Property in Sec.

Register of Deeds Stamp & File Number

4. Lot No. , Recorded Plat
5. Private Claims

Grid table with columns A-M and rows 1-13. Contains numerical data for recording purposes.

I, ARTHUR R. RANGER, in a field survey on JUNE 07, 1997 do hereby state that under requirements of P.A. 74, Michigan P.A. of 1970, the corner points mentioned in lines 1 and 2 above were in conformance with regulations and rules therefore as required in the current manual of survey instructions of the United States Department of the Interior, Bureau of Land Management or by a decree of a Court of Law and for that the corner points mentioned in lines 3, 4 and 5 above were in conformance with the rules of the Michigan Board of Land Surveyors or by a Decree of a Court of Law; established, re-established, monumented, recovered, found as expressed below:

NOTE: Not more than 2 corners, all in the same town and range, may be recorded on this certificate.

A. Description of original monument and accessories and/or subsequent restoration:

- List of survey descriptions and monument details, including references to previous surveys and monuments found.


B. Description of corner evidence found and/or method applied in restoring or reestablishing corner:

-1 1/4 corner common to Sec. 1, T.32N., R.6W. & Sec. 36, T.33N., R.6W.
1997- Arthur R. Ranger found the Charlevoix County Monument, and witnesses of record; The corner fits surveys and existing monumentation in the area.

C. Description of monument for corner and accessories established to perpetuate locating the position of the corner:

-1 1/4 corner common to Sec. 1, T.32N., R.6W. & Sec. 36, T.33N., R.6W.
(Found a Charlevoix County Monument)
P.P. WEST 9.64'
MANHOLE NORTH 22.3'
MAPLE 14" N24°W 122.50'
S.W. BOLT ON LT. POLE N08°E 75.83'

Charlevoix Co. Surveyor
APPROVED
Signature Mary C. Feindt
Date: Sept 14, 1997

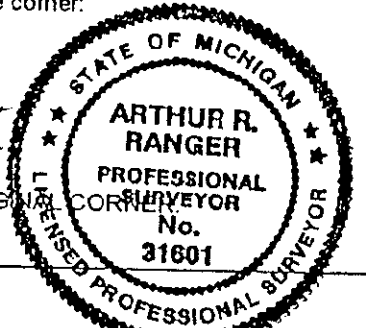

AND IS ACCEPTED AS A CAREFUL AND FAITHFUL PERPETUATION OF THE POSITION OF THE ORIGINAL CORNER

Signed by Arthur R. Ranger

Date Sept 10, 1997

Surveyor's Michigan License No. 31601

LIB# 003 and 120