

MICHIGAN  
DEPARTMENT OF CONSERVATION  
FORESTRY DIVISION

# LAND CORNER RECORD

T. 33 N. R. 4W


Charlevoix COUNTY

DESCRIPTION OF CORNER 1/4 corner common to Sections 9 - 10

CORNER MONUMENT Set 1" pipe with 4" aluminum cap 6" below surface.

DATE MONUMENT PLACED AND WITNESSED 11-22-61

WITNESSES TO CORNER.....

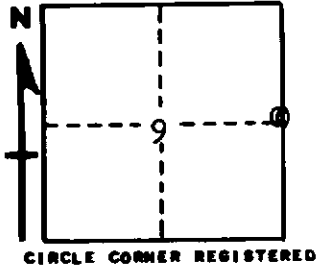

10" R. Pine - S 38 W - 65.5 feet

14" Elm - N 78 E - 19.5 feet

AND

DESCRIPTION IN DETAIL AS TO HOW CORNER WAS LOCATED AND IDENTIFIED OR RESTORED.

This corner was restored while making a survey in this township. Found evidence of old post bottom in center of N-S road, within 2 links of the calculated midpoint on line position. Consider this a restoration of the 1/4 corner established in old state road survey, and identified in a 1905 survey of record in Section 10.

SURVEYOR'S SEAL

SIGNED *Kenneth J. Ostling* DATE 11/28/61  
REGISTERED LAND SURVEYOR