

MICHIGAN
DEPARTMENT OF CONSERVATION
FORESTRY DIVISION

LAND CORNER RECORD


T. 33 N.R. 4 W
T. 33 N.R. 5 W Charlevoix COUNTY

DESCRIPTION OF CORNER Section corner common to Sections 6 - 7 - 1 - 12

CORNER MONUMENT 1" pipe with 4" aluminum cap

DATE MONUMENT PLACED AND WITNESSED 12-6-61

WITNESSES TO CORNER.....

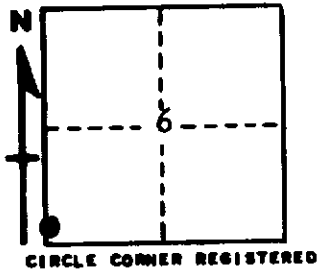

16" H. Maple	-	N 55 E	-	23.5 feet
5" H. Maple	-	S 56 E	-	23.4 feet
AND 5" H. Maple	-	S 49 W	-	23.5 feet

DESCRIPTION IN DETAIL AS TO HOW CORNER WAS LOCATED AND IDENTIFIED OR RESTORED.

This corner was restored while making a survey in this area. Set corner by proportionate measurement between 1/4 corner south and town corner north. This point falls well in line with old road grade north, and is approximately 2 rods west and 2 rods south of old field fence corner. No other evidence available.

SURVEYOR'S SEAL

SIGNED *Kenneth J. Bethune* DATE 12/12/61
REGISTERED LAND SURVEYOR