

MICHIGAN
DEPARTMENT OF CONSERVATION
FORESTRY DIVISION

LAND CORNER RECORD


T. 33 N.R. 4 W T. 33 N.R. 5W
T. 34 N.R. 4 W T. 34 N.R. 5W
Emmet - Charlevoix COUNTY

DESCRIPTION OF CORNER Section corner common to Sections 1 - 6 - 31 - 36

CORNER MONUMENT 1" pipe with 4" aluminum cap 4" below surface.

DATE MONUMENT PLACED AND WITNESSED 12-6-61

WITNESSES TO CORNER.....

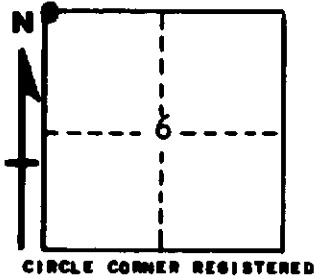

8" Elm	-	S 40 E	-	30.0 feet
14" Elm	-	S 52 W	-	21.2 feet
AND				
5" R. Pine	-	N 16 E	-	70.4 feet

DESCRIPTION IN DETAIL AS TO HOW CORNER WAS LOCATED AND IDENTIFIED OR RESTORED.

This corner was restored while making a survey in T33N R4W. Unable to locate any previous corner. Set this corner on line over Section and 1/4 Corner east, at U.S. record measurement from existing 1/4 corner. This location places corner a proportionate measurement for latitude between road intersection 1 mile north and 1/4 corner to Sections 7 and 12 south. It also checks county surveyor's record to 1/8 line fence and 1/4 line road west. Falls in line with old township road grade south. This method seemed most in accord with the U.S. record, while conforming very well with surrounding lines of occupation.

SURVEYOR'S SEAL

SIGNED *Kenneth J. O'Connell* DATE 12/12/61
REGISTERED LAND SURVEYOR