

LAND CORNER RECORDATION CERTIFICATE

FILING REQUIREMENT OF ACT 74, MICH. P.A.1970

FOR CORNERS OF--:	LOCATED IN--:	CORNER CODE NUMBER
1. PUBLIC LAND SURVEY _____	T. <u>33</u> N. <u>0.</u> , R. <u>4</u> E. <u>0.</u>	<u>B-9;</u>
2. PROPERTY CONTROLLING IN SECTION <u>20</u>	, T. <u>33</u> N. <u>0.</u> , R. <u>4</u> E. <u>0.</u>	<u>3</u>
3. MISCELLANEOUS PROPERTY IN SECTION _____	, T. _____ N. _____, R. _____ E. _____	_____
4. LOT NO. _____, RECORDED PLAT _____		
5. PRIVATE CLAIMS _____		

REGISTER OF DEEDS STAMP AND FILING NUMBER

I, Carl F. Roser, do hereby certify that under requirements of P.A. 74, Michigan P.A. of 1970, the corner points mentioned in lines 1 and 2 above were, in a field survey on December 3, 1985, established, re-established, monumented, re-monumented, recovered or restored as expressed below and in conformance with regulations and rules therefore as required in the current manual of survey instructions of the United States Department of the Interior, Bureau of Land Management or by a decree of a court of law. Furthermore, that the corner points mentioned in lines 3, 4 and 5 above were, in a field survey on _____, 19____, found, recovered, restored, established or re-established as expressed below and in conformance with the rules of the Michigan State Board of Registration for Land Surveyors or, by a Decree of a Court of law:

A. Description of original monument and accessories and/or subsequent restoration:

B. Description of corner evidence found and/or method applied in restoring or re-establishing corner:
 3 - Fd. & accepted "T" iron w/cap for SW corner of NW $\frac{1}{4}$ -NW $\frac{1}{4}$ of Section 20 as set by Larry Feindt. Larry re-established this corner after discussions with C. Roser - Spring 1985. Also see corner record for W 1/4 corner of Section 20.

B-9 - Recovered pointed post bottom which fit two E.K. Robinson B.T. (stumps). See Bk. #91, pg. 21, June 1898, where E.K. Robinson re-estab. the N 1/4 corner of Section 30 pro-rated to U.S. (G.L.O.)

C. Description of monument for corner and accessories established to perpetuate locating the position of the corner:

<u>3</u>		<u>B-9</u>
Fd "T" iron w/cap #21566 & 25834 added cedar post		Fd. E.K.R. pointed post bottom, replaced w/DNR monument & set cedar post
3" Ash N40°W 22.65'		13" Tamarack N30°E 15.3'
12" Oak S85°W 36.84'		12" Tamarack S70°E 28.7'
4" Ash S20°W 14.65'		12" Tamarack S02°E 33.9'
		18" Tamarack N70°W 34.1'
		12" Cedar stp w/blaze N62°W 9.2'
		24" White Pine stp S39°W 13.2'

SIGNED BY Carl F. Roser 02-07-86 DATE _____

SURVEYOR'S MICHIGAN REGISTRATION NO. 12028


FOR STATE AND UNITED STATES AGENCIES:

SIGNED BY _____ DATE _____

CHIEF OF SURVEY PARTY

APPROVED AND SIGNED BY _____ DATE _____

MICHIGAN REGISTERED LAND SURVEYOR

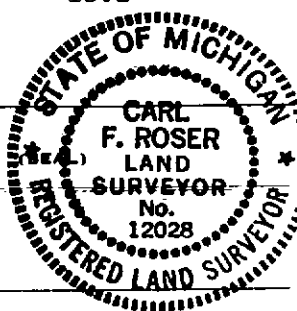

(SEAL)

SURVEYOR'S MICHIGAN REGISTRATION NO. _____ CHARLEVOIX COUNTY

FORM APPROVED BY MICHIGAN STATE BOARD OF REGISTRATION, JAN. 28, 1971
REVISED MAY 14, 1975

MAY PLACE SKETCH ON BACK OR ATTACHED SHEET