

LAND CORNER RECORDATION CERTIFICATE

FILING REQUIREMENT OF ACT 74, MICH. P.A.1970

FOR CORNERS OF--:	LOCATED IN--:	CORNER CODE NUMBER
1. PUBLIC LAND SURVEY _____	T. <u>33</u> N. <u>4</u> R. <u>4</u> W.	<u>B-6;B-5;C-5;C-6</u>
2. PROPERTY CONTROLLING IN SECTION _____	T. _____ N. _____ S. _____ R. _____ E. _____ W. _____	_____
3. MISCELLANEOUS PROPERTY IN SECTION _____	T. _____ N. _____ S. _____ R. _____ E. _____ W. _____	_____
4. LOT NO. _____, RECORDED PLAT _____		
5. PRIVATE CLAIMS _____		

REGISTER OF DEEDS STAMP AND FILING NUMBER

I, Carl F. Roser, do hereby certify that under requirements of P.A. 74, Michigan P.A. of 1970, the corner points mentioned in lines 1 and 2 above were, in a field survey on December 5, 1985, established, re-established, monumented, re-monumented, recovered or restored as expressed below and in conformance with regulations and rules therefore as required in the current manual of survey instructions of the United States Department of the Interior, Bureau of Land Management or by a decree of a court of law. Furthermore, that the corner points mentioned in lines 3, 4 and 5 above were, in a field survey on _____, 19____, found, recovered, restored, established or re-established as expressed below and in conformance with the rules of the Michigan State Board of Registration for Land Surveyors or, by a Decree of a Court of law:

C. (Continued):

C-5			C-6		
Fd. Dept. mon. & set cedar post			Fd. 3/4" pipe w/RLS cap #3920 & set cedar post w/loc tag		
7" Maple	S36°E	33.6'	4" Maple	N22°E	15.43'
7" White Birch	S06°W	31.0'	4" Maple	S45°E	4.53'
12" Maple	N45°W	44.7'	11" Twin Maple	S80°W	11.02'
P. Pole	N50°E	53.36'	10" Maple	N36°W	24.12'

- B. Description of corner evidence found and/or method applied in restoring or re-establishing corner:
- B-6 - Establish ctr. of Sec. 18 at intersection of 1/4 lines. Corner falls 1'± south of ctr. of old E-W road grade (road was cut out of hill side).
 - B-5 - Found 1" pipe by E.A. Robinson, Dec. 1916. See Chandler Bk., pg. 3; at Jury Room in courthouse.
 - C-5 - Previous Dept. corner of record (1961). Fits E.A. Robinson survey of Sec. 17, dated 1902 & 1916; see Chandler Field Bk., pg. 3&16 at Jury Room in courthouse. K.J.O., 1961 says Fd. 1" pipe as called for by E.A. Robinson in 1916.
 - C-6 - Fd. & accepted 3/4" pipe, that fits RLS, Mary Feindts wits., for 1/4 corner common to Sec's 17&18. Fits E.A. Robinson survey of Sec. 17, dated 1902.

C. Description of monument for corner and accessories established to perpetuate locating the position of the corner:

B-6			B-5		
Drove 5/8" x 34" reroed w/RLS cap			Fd. 1" pipe; replaced w/DNR mon. & set cedar post		
7" Maple	N20°E	12.2'	8" Maple	N20°E	8.5'
4" Maple	S10°E	10.0'	7" Twin Maple	S30°E	20.2'
14" Maple	S50°W	18.8'	7" Maple	S70°W	7.1'
7" Maple	N20°W	13.8'	7" Tri. Maple	N35°W	6.9'
Set cedar post w/loc tag	North	16.5'			

SIGNED BY Carl F. Roser 02-07-86 DATE _____

SURVEYOR'S MICHIGAN REGISTRATION NO. 12028


FOR STATE AND UNITED STATES AGENCIES:

SIGNED BY _____ DATE _____

CHIEF OF SURVEY PARTY

APPROVED AND SIGNED BY _____ DATE _____

MICHIGAN REGISTERED LAND SURVEYOR

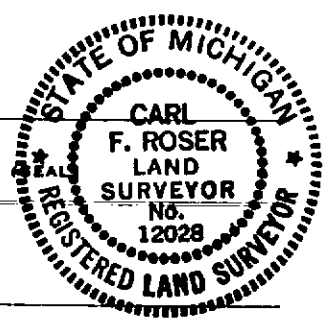

(SEAL)

SURVEYOR'S MICHIGAN REGISTRATION NO. _____ CHARLEVOIX COUNTY