

LAND CORNER RECORDATION CERTIFICATE

FILING REQUIREMENT OF ACT 74, MICH. P.A.1970

FOR CORNERS OF--:	LOCATED IN--:	CORNER CODE NUMBER
1. PUBLIC LAND SURVEY _____	T. <u>33</u> N. <u>4</u> R. <u>4</u> W.	G-11; G-12
2. PROPERTY CONTROLLING IN SECTION _____	T. _____ N. _____ S. _____ R. _____ E. _____ W. _____	_____
3. MISCELLANEOUS PROPERTY IN SECTION _____	T. _____ N. _____ S. _____ R. _____ E. _____ W. _____	_____
4. LOT NO. _____, RECORDED PLAT _____		
5. PRIVATE CLAIMS _____		

REGISTER OF DEEDS STAMP AND FILING NUMBER

I, Carl F. Roser, do hereby certify that under requirements of P.A. 74, Michigan P.A. of 1970, the corner points mentioned in lines 1 and 2 above were, in a field survey on December 23, 1985, established, re-established, monumented, re-monumented, recovered or restored as expressed below and in conformance with regulations and rules therefore as required in the current manual of survey instructions of the United States Department of the Interior, Bureau of Land Management or by a decree of a court of law. Furthermore, that the corner points mentioned in lines 3, 4 and 5 above were, in a field survey on _____, 19____, found, recovered, restored, established or re-established as expressed below and in conformance with the rules of the Michigan State Board of Registration for Land Surveyors or, by a Decree of a Court of law:

A. Description of original monument and accessories and/or subsequent restoration:

B. Description of corner evidence found and/or method applied in restoring or re-establishing corner:

G-11 - Restored NW cor. of Sec. 34 at double distance & on line across fd. E.A. Robinson's (1905) W $\frac{1}{2}$ Cor. & N 1/8 Cor. on W. line of Sec. 34; See Chandler Book (33-4), pgs. 24-39, notes in Jury Room in Gov't Bldg. Fits E.A. Robinson's Sec. 34 Sur. & Sec. Sub'n. Ctr of E-W power line is 40'± south. Put 18" x 10" rock & 7" dia. rock along side DNR mon.

G-12 - Re-established W $\frac{1}{2}$ Cor. Sec. 34 (fd. stk. hole) from 1905 E.A. Robinson 8" Hemlock B.T. (now 15" & 1/3 rotted) N21 $\frac{1}{2}$ °E, 11.9'. Fits his boundary & Sec. 34 Sub'n.; E.A. Robinson had U.S. B.T., see Chandler Book of County Surveyors Records at County House, pages 27 & 29.

C. Description of monument for corner and accessories established to perpetuate locating the position of the corner:

G-11	G-12	
Set DNR monument & cedar post	Set DNR monument and cedar post	
9" Oak N26°E 3.1'	10" Ash S43°W 12.7'	
6" Maple N26°W 6.9'	6" Maple S32°E 17.9'	
10" Oak S25°W 12.9'	14" Red Oak S56°E 35.4'	
8" Oak S76°E 25.6'	15" Hemlock N21 $\frac{1}{2}$ °E 11.5'	
	Irregular N-S Tr.Rd. West 62'±	


SIGNED BY Carl F. Roser 02-07-86 DATE _____

SURVEYOR'S MICHIGAN REGISTRATION NO. 12028

FOR STATE AND UNITED STATES AGENCIES:

SIGNED BY _____ DATE _____

APPROVED AND SIGNED BY _____ DATE _____

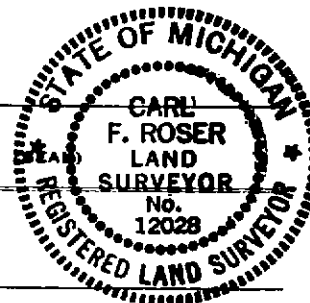

(SEAL)

SURVEYOR'S MICHIGAN REGISTRATION NO. _____ CHARLEVOIX COUNTY

FORM APPROVED BY MICHIGAN STATE BOARD OF REGISTRATION, JAN. 26, 1971
REVISED MAY 14, 1975

MAY PLACE SKETCH ON BACK OR ATTACHED SHEET