

LAND CORNER RECORDATION CERTIFICATE

FILING REQUIREMENT OF ACT 74, MICH. P.A.1970

FOR CORNERS OF--:	LOCATED IN--:	CORNER CODE NUMBER
1. PUBLIC LAND SURVEY _____	T. <u>33</u> N. <u>●</u> , R. <u>4</u> W. <u>●</u>	<u>E-13; D-13</u>
2. PROPERTY CONTROLLING IN SECTION _____	, T. _____ N. _____ S. _____ R. _____ E. _____ W. _____	_____
3. MISCELLANEOUS PROPERTY IN SECTION _____	, T. _____ N. _____ S. _____ R. _____ E. _____ W. _____	_____
4. LOT NO. _____, RECORDED PLAT _____		
5. PRIVATE CLAIMS _____		

REGISTER OF DEEDS STAMP AND FILING NUMBER

I, Carl F. Roser, do hereby certify that under requirements of P.A. 74, Michigan P.A. of 1970, the corner points mentioned in lines 1 and 2 above were, in a field survey on December 20, 1985, established, re-established, monumented, re-monumented, recovered or restored as expressed below and in conformance with regulations and rules therefore as required in the current manual of survey instructions of the United States Department of the Interior, Bureau of Land Management or by a decree of a court of law. Furthermore, that the corner points mentioned in lines 3, 4 and 5 above were, in a field survey on _____, 19____, found, recovered, restored, established or re-established as expressed below and in conformance with the rules of the Michigan State Board of Registration for Land Surveyors or, by a Decree of a Court of law:

- B. (Continued):**
~~Description of original monument and accessories and/or subsequent restoration:~~
 E-13 - as there is a large over-run from 80 ch. N. bet. Sections 32 & 33 (33-4) & stream 20 links wide at 45 chains N. does not exist (line was probably run south from 3 or 6 miles North).
 D-13 - Restored 1/4 Cor. mid-way & on line between Sec. Corners to E&W. Fd. Schaaf 2" pipe (set pipe down flush w/ground), N26°15"E, 57.1'.


B. Description of corner evidence found and/or method applied in restoring or re-establishing corner:
 E-13 - Restored Sec. Cor. Comm. to Sections 32 & 33 (T33N-R4W) & 4 & 5 (T32N-R4W) per E.A. Robinson, May 1906, survey of N. line of Sec. 4 (32-4); see book C-296, Hudson (32-4), pg. 3., notes on file in Jury Room at Ct.Hse. We recovered E.A. Robinson's N 1/4 Cor. Sec. 4 (he had both U.S. B.T.s) & NE Cor. Sec. 4 (he had one U.S. B.T.) & set NW Sec. 4 at rec. E.A. Robinson defl. angle at N 1/4 Cor. (00°15') & pro-rated distance to his measurements; taking into consideration that his E 1/2 mile was more hilly than his W 1/2 mile. Restored NW Sec. 4 fits record U.S. (G.L.O.) 1850 distance south 1 mile to fd. SW Sec. 4 (R.R. rail - E.A. Robinson, Bk. 6, pg. 38, July 1904). U.S. call to enter Swp. 5-ch. north is extremely indefinite; suspect U.S. 1841 line note's to be in error

C. Description of monument for corner and accessories established to perpetuate locating the position of the corner:

E-13	D-13
Set DNR Mon. & Cedar Post	Set DNR Mon. & Cedar Post
4" Maple N30°W 67.0'	7" Maple N28°W 7.1'
3" Maple S30°E 29.9'	9" Maple S72°E 13.6'
6" Maple S10°W 36.2'	4" Maple S28°E 23.6'
4" Maple S70°W 44.0'	4" Ironwood S08°W 13.0'
Fd. incorrect Schaaf	E-W Trail North 113'±
2" pipe (lowered flush) N29°06'E 114.6'	

SIGNED BY Carl F. Roser 02-07-86 DATE _____

SURVEYOR'S MICHIGAN REGISTRATION NO. 12028

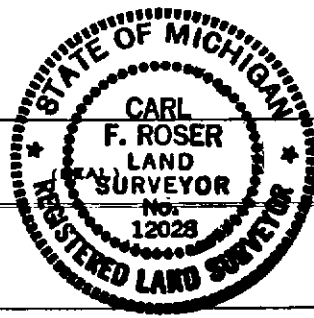

FOR STATE AND UNITED STATES AGENCIES:

SIGNED BY _____ DATE _____
CHIEF OF SURVEY PARTY

APPROVED AND SIGNED BY _____ DATE _____
MICHIGAN REGISTERED LAND SURVEYOR

SURVEYOR'S MICHIGAN REGISTRATION NO. _____ CHARLEVOIX COUNTY

MAY PLACE SKETCH ON BACK OR ATTACHED SHEET