

99 NOV 11 PM 2:55

LAND CORNER RECORDATION CERTIFICATE
 Filing Requirement of Act 74, Mich. P.A. 1970

Charles M. Justice
 REGISTER OF DEEDS

For corners in
 CHANDLER TWP

CHARLEVOIX
 (County)

Located In:

Corner Code #

- | | | |
|------------------------------------|--------------------------|------------|
| 1. Public Land Survey | T <u>33N</u> R <u>4W</u> | <u>C-1</u> |
| | T _____ R _____ | _____ |
| | T _____ R _____ | _____ |
| | T _____ R _____ | _____ |
| 2. Property Controlling in Section | S _____ T _____ R _____ | _____ |
| | S _____ T _____ R _____ | _____ |
| 3. Miscellaneous Property in Sec. | S _____ T _____ R _____ | _____ |
| | S _____ T _____ R _____ | _____ |

RECORDED

FEB 11 2000

SECTION

Register of Deeds Stamp & File Number

4. Lot No. _____, Recorded Plat _____

5. Private Claims _____

I, JAMES E. EVANS, in a field survey on MARCH 15, 1999 do hereby state that under requirements of P.A. 74, Michigan P.A. of 1970, the corner points mentioned in lines 1 and 2 above were in conformance with regulations and rules therefore as required in the current manual of survey instructions of the United States Department of the Interior, Bureau of Land Management or by a decree of a Court of Law and /or that the corner points mentioned in lines 3, 4 and 5 above were in conformance with the rules of the Michigan Board of Land Surveyors or by a Decree of a Court of Law; established, re-established, monumented, recovered, found as expressed below:

NOTE: Not more than 2 corners, all in the same town and range, may be recorded on this certificate.

A. Description of original monument and accessories and/or subsequent restoration:

C-1 SECTION CORNER COMMON TO SECTIONS 5 & 6 T33N-R4W
 GENERAL LAND OFFICE

Set post
 Tamarack 6" S10°W 30 Links (19.80')
 Tamarack 6" S20°E 35 Links (23.10')
 Aug 22, 1841
 By: Ch. W. Cathcart D.S.

B. Description of corner evidence found and/or method applied in restoring or reestablishing corner:

C-1 SECTION CORNER COMMON TO SECTIONS 5 & 6 T33N-R4W

Kenneth J. Ostling PS #10068 Dec. 12, 1961 Set a 1" pipe with 4" Aluminum Cap 7" Balsam S32°E 13.6' (1) 5" Cedar S29°W 7.2' (2)	John Ferguson PS #24595 LCRC Liber 2 Pg 157 Found DNR monument June 17, 1982 6" Cedar N05°E 9.80' (3) 30" W. Pine N30°E 19.35' (4) 6" Cedar S10°W 8.95' (2) 8" Balsam S20°E 13.65' (1)
---	---

Charlevoix Co. Surveyor
APPROVED

Signature Mary C. Feendt
 Date: Nov. 11, 1999


Distance to corner B-1 Measured 2631.34' (GLO = 2640.0')
 Distance to corner D-1 Measured 2574.22' (GLO = 2640.0')
 Distance to C-13 T34N R4W 22.63' (GLO = 23.1')

C. Description of monument for corner and accessories established to perpetuate locating the position of the corner:

C-1 SECTION CORNER COMMON TO SECTIONS 5 & 6 T33N-R4W

Found DNR Pipe with Aluminum Cap in good shape.

WITNESSES: 22" W. Pine (dead) N58°E 19.43'	Found spike in SE side (4)
8" Cedar N25°E 9.85'	Found spike in SW side (3)
7" Cedar S35°W 6.68'	Found spike in NE side
7" Cedar S85°E 46.20'	Found blaze on West side
DNR disk N90°E 22.63'	Record = 23.10'

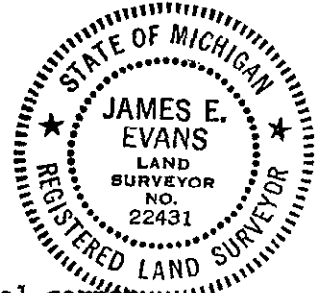

And is accepted as the best available evidence of the position of the original corner

Signed by [Signature]

Date 11-11-99

Surveyor's Michigan License No. 22431