

99 NOV 11 PM 2:56

LAND CORNER RECORDATION CERTIFICATE  
Filing Requirement of Act 74, Mich. P.A. 1970

*Charlene M. Neutrop*

For corners in  
CHANDLER TWP  
CHARLEVOIX  
(County)

Located In: Corner Code #

- 1. Public Land Survey T 33N R 4 W D-1  
T      R       
T      R       
T      R
- 2. Property Controlling S      T      R       
in Section S      T      R
- 3. Miscellaneous S      T      R       
Property in Sec. S      T      R

REGISTER OF DEEDS

RECORDED

FEB 01 2000

SECTION

Register of Deeds Stamp & File Number

4. Lot No. \_\_\_\_\_, Recorded Plat \_\_\_\_\_

5. Private Claims \_\_\_\_\_

I, JAMES E. EVANS, in a field survey on MARCH 15, 1999 do hereby state that under requirements of P.A. 74, Michigan P.A. of 1970, the corner points mentioned in lines 1 and 2 above were in conformance with regulations and rules therefore as required in the current manual of survey instructions of the United States Department of the Interior, Bureau of Land Management or by a decree of a Court of Law and for that the corner points mentioned in lines 3, 4 and 5 above were in conformance with the rules of the Michigan Board of Land Surveyors or by a Decree of a Court of Law; established, re-established, monumented, recovered, found as expressed below:

NOTE: Not more than 2 corners, all in the same town and range, may be recorded on this certificate.

A. Description of original monument and accessories and/or subsequent restoration:  
D-1 NORTH QUARTER CORNER SECTION 5 T33N-R4W

GENERAL LAND OFFICE

THIS CORNER WAS NOT SET BY THE GLO.

B. Description of corner evidence found and/or method applied in restoring or reestablishing corner:  
D-1 NORTH QUARTER CORNER SECTION 5 T33N-R4W

No evidence of corner was found. There was no work done in this section by the DNR or any past county surveyors.

John Ferguson reset the South quarter corner of section 32 T34N- R4W (D-13) half way on line between the Emmet County corners (see LCRC Liber 2 Pg 101).

D-1 was reestablished at record distance from the Emmet County corner set by Ferguson.

Distance to corner C-1 Measured 2574.22' (GLO = 2640.0')  
Distance to corner E-1 Measured 2574.93' (GLO = 2640.0')  
Distance to D-13 T34N R4W 21.45' (GLO = 21.45')


Charlevoix Co. Surveyor  
**APPROVED**  
Signature Mary C. Bennett  
Date: Nov 11 1999

C. Description of monument for corner and accessories established to perpetuate locating the position of the corner:  
D-1 NORTH QUARTER CORNER SECTION 5 T33N-R4W

Set Charlevoix County cast iron monument at computed location as described above  
Corner falls in wooded area with no fences or occupation.

WITNESSES:

12" Cedar	S10°W	30.94'	Set pk nail & tag in West side
12" Hemlock	N65°E	7.15'	Set pk nail & tag in NW side
12" Tw. Cedar	N45°W	18.40'	Set pk nail & tag in South side
9" Cedar	S73°W	12.71'	Set pk nail & tag in North side
1/2" rebar	N90°E	21.45'	Record = 21.45'

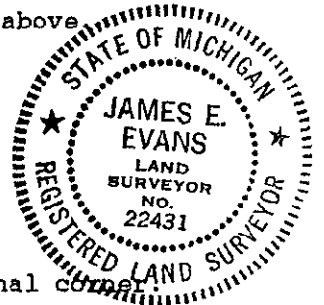

And is accepted as the best available evidence of the position of the original corner.

Signed by *James E. Evans*

Date 11-11-99

Surveyor's Michigan License No. 22431