

99 NOV 11 PM 2:58

LAND CORNER RECORDATION CERTIFICATE
Filing Requirement of Act 74, Mich. P.A. 1970

Charles M. Juvonny

REGISTER OF DEEDS

For corners in
CHANDLER TWP

CHARLEVOIX
(County)

Located In:

Corner Code #

1. Public Land Survey		T <u>33N</u> R <u>4 W</u>	<u>F-1</u>
		T _____ R _____	_____
		T _____ R _____	_____
		T _____ R _____	_____
2. Property Controlling in Section	S _____	T _____ R _____	_____
	S _____	T _____ R _____	_____
3. Miscellaneous Property in Sec.	S _____	T _____ R _____	_____
	S _____	T _____ R _____	_____

RECORDED

FEB 03 2000

SECTION
Register of Deeds Stamp & File Number

4. Lot No. _____, Recorded Plat _____

5. Private Claims _____

I, JAMES E. EVANS, in a field survey on MARCH 15, 1999 do hereby state that under requirements of P.A. 74, Michigan P.A. of 1970, the corner points mentioned in lines 1 and 2 above were in conformance with regulations and rules therefore as required in the current manual of survey instructions of the United States Department of the Interior, Bureau of Land Management or by a decree of a Court of Law and/or that the corner points mentioned in lines 3, 4 and 5 above were in conformance with the rules of the Michigan Board of Land Surveyors or by a Decree of a Court of Law; established, re-established, monumented, recovered, found as expressed below:

NOTE: Not more than 2 corners, all in the same town and range, may be recorded on this certificate.

A. Description of original monument and accessories and/or subsequent restoration:
F-1 NORTH QUARTER CORNER SECTION 4 T33N-R4W

GENERAL LAND OFFICE

THIS CORNER WAS NOT SET BY THE GLO.

B. Description of corner evidence found and/or method applied in restoring or reestablishing corner:
F-1 NORTH QUARTER CORNER SECTION 4 T33N-R4W

No evidence of corner was found.

E. A. Robinson found the South 1/4 corner of section 33 T34N- R4W (F-13) in 1909 and set an iron rod at the GLO location. He also computed corner F-1 to be 54 links west of the Emmet corner (35.64') as opposed to the GLO distance of 40 links (26.40').


D-1 was reestablished at Robinson's distance from the Emmet corner F-13 as this is almost half way between corners E-1 and G-1.

Distance to corner E-1 Measured 2608.30' (Robinson = 2608.98' GLO = 2640.0')
Distance to corner G-1 Measured 2610.52' (Robinson = 2609.64' GLO = 2640.0')
Distance to F-13 T34N R4W 35.64' (Robinson = 35.64' GLO = 26.4')

C. Description of monument for corner and accessories established to perpetuate locating the position of the corner:
F-1 NORTH QUARTER CORNER SECTION 4 T33N-R4W

Set Charlevoix County cast iron monument at computed location as described above.

WITNESSES:	11" Beech	S88°E	40.78'	Set pk nail & tag in North side
	18" Cherry	N28°E	40.78'	Set pk nail & tag in SE side
	5" Ash	N64°W	6.33'	Set pk nail & tag in South side
	4" Ironwood	S03°E	30.08'	Set pk nail & tag in NW side
	Axle shaft	N90°E	35.64'	Record = 26.4'

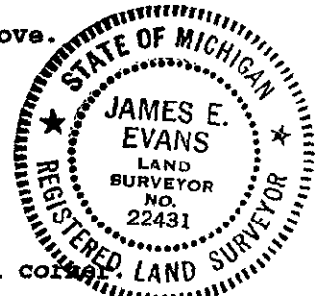

And is accepted as the best available evidence of the position of the original corner.

Signed by *James E. Evans*

Date 11-11-99

Surveyor's Michigan License No. 22431