

NOV 21 1997

CONVINCED

STATE OF MICHIGAN  
COUNTY OF CHARLEVOIX  
RECEIVED FOR RECORD

97 OCT -9 PII 3:27

LAND CORNER RECORDATION CERTIFICATE  
Filing Requirement of Act 74, Mich. P.A. 1970

*Charles M. Fernald*  
REGISTER OF DEEDS

For corners in

CHARLEVOIX (County)	Located In:	Corner Code #
1. Public Land Survey	T 33N R 4W	H-1
	T _____ R _____	_____
	T _____ R _____	_____
	T _____ R _____	_____
2. Property Controlling in Section	S _____ T _____ R _____	_____
	S _____ T _____ R _____	_____
3. Miscellaneous Property in Sec.	S _____ T _____ R _____	_____
	S _____ T _____ R _____	_____

Register of Deeds Stamp & File Number

4. Lot No. \_\_\_\_\_, Recorded Plat \_\_\_\_\_

5. Private Claims \_\_\_\_\_

I, James E. Evans, in a field survey on Sept 2, 1997 do hereby state that under requirements of P.A. 74, Michigan P.A. of 1970, the corner points mentioned in lines 1 and 2 above were in conformance with regulations and rules therefore as required in the current manual of survey instructions of the United States Department of the Interior, Bureau of Land Management or by a decree of a Court of Law and /or that the corner points mentioned in lines 3, 4 and 5 above were in conformance with the rules of the Michigan Board of Land Surveyors or by a Decree of a Court of Law; established, re-established, monumented, recovered, found as expressed below:

	A	B	C	D	E	F	G	H	I	J	K	L	M
1													
2		6		5		4		3		2		1	
3													
4		7		8		9		10		11		12	
5													
6		18		17		16		15		14		13	
7													
8		19		20		21		22		23		24	
9													
10		30		29		28		27		26		25	
11													
12		31		32		33		34		35		36	
13													

NOTE: Not more than 2 comers, all in the same town and range, may be recorded on this certificate.

A. Description of original monument and accessories and/or subsequent restoration:  
H-1 North Quarter corner of Section 3 T33N - R4W

GLO did not set this corner

Mich. Dept of Conservation  
7-28-60 By Kenneth Ostling RLS #10068  
Set 1" pipe with 4" brass cap  
12" Basswood S71°W 3 1/2 lks ( 2.31'  
12" Maple S83°E B 1/2 lks ( 5.61')

B. Description of corner evidence found and/or method applied in restoring or reestablishing corner:  
H-1 North Quarter corner of Section 3 T33N - R4W

Found Dept. of Conservation brass cap 15' South of the center line of an East/West gravel road.  
Corner is 0.06 ft South of township line  
Did not find any old witnesses


GLO Comp to I-1 = 2640' Meas = 2624.53'  
GLO Comp to G-1 = 2640' Meas = 2622.16'  
GLO Comp to H-13 = 26.40 (40 lks) Meas = 26.54'

Charlevoix Co. Surveyor  
**APPROVED**  
Signature *Mary C. Fernald*  
Date: 10-9-97

C. Description of monument for corner and accessories established to perpetuate locating the position of the corner:  
H-1 North Quarter corner of Section 3 T33N - R4W

DEPARTMENT OF CONSERVATION BRASS CAP.

17"	BASSWOOD	N22°E	33.40'	SET NAIL & CAP #22431 IN SW SIDE
10"	MAPLE	N73°E	24.63'	SET NAIL & CAP #22431 IN SW SIDE
23"	MAPLE	N24°E	45.72'	SET NAIL 7 CAP #22431 IN NW SIDE
17"	RED PINE	N89°E	6.17'	SET NAIL & CAP #22431 IN SOUTH SIDE

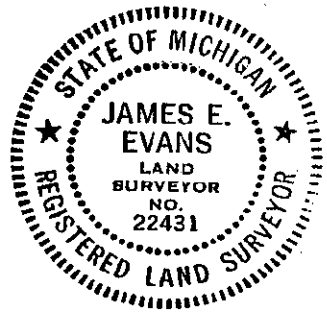

THIS POSITION WAS NOT ESTABLISHED BY ORIGINAL GOVERNMENT SURVEY. THIS MONUMENT IS ACCEPTED AS A CAREFUL AND FAITHFUL DETERMINATION OF THE POSITION OF THE CORNER.

Signed by *James E. Evans* Date 10-9-97

Surveyor's Michigan License No. 22431

LIBEF 303 PAGE 108