

**SURVEY &
REMONUMENTATION**

DEC 16 1996

COMMISSION

STATE OF MICHIGAN
COUNTY OF CHARLEVOIX
RECORDED FOR RECORD

96 NOV 13 PM 4:48

LAND CORNER RECORDATION CERTIFICATE
Filing Requirement of Act 74, Mich. P.A. 1970

Charles M. Barber
REGISTER OF DEEDS

For corners in
CHARLEVOIX
(County)

	Located In:	Corner Code #/
1. Public Land Survey	T <u>33N</u> R <u>4W</u>	<u>H-13</u>
	T _____ R _____	_____
	T _____ R _____	_____
	T _____ R _____	_____
2. Property Controlling in Section	S _____ T _____ R _____	_____
	S _____ T _____ R _____	_____
3. Miscellaneous Property in Sec.	S _____ T _____ R _____	_____
	S _____ T _____ R _____	_____
4. Lot No. _____, Recorded Plat _____		
5. Private Claims _____		

Register of Deeds Stamp & File Number

	A	B	C	D	E	F	G	H	I	J	K	L	M
2	6	5	4	3	2	1							
3													
4	7	8	9	10	11	12							
5													
6	18	17	16	15	14	13							
7													
8	19	20	21	22	23	24							
9													
10	30	29	28	27	26	25							
11													
12	31	32	33	34	35	36							
13													

I, ARTHUR R. RANGER, in a field survey on SEPT. 11, 19 93, do hereby certify that under requirements of P.A. 74, Michigan P.A. of 1970, the corner points mentioned in lines 1 and 2 above were in conformance with regulations and rules therofore as required in the current manual of survey instructions of the United States Department of the Interior, Bureau of Land Management or by a decree of a Court of Law and/or that the corner points mentioned in lines 3, 4 and 5 above were in conformance with the rules of the Michigan Board of Land Surveyors or by a Decree of a Court of Law; established, re-established, monumented, re-monumented, recovered, found as expressed below:

NOTE: Not more than 4 corners, all in the same town and range, may be recorded on this certificate.

A. Description of original monument and accessories and/or subsequent restoration:

H-13 GLO - Set Qr. section post - Beech 8" N36°E 25 lks; Sugar 10" N5°W 10 lks

E.K. Robinson reset Qr. post in a survey dated 1881 - Beech 8" N36°E 25 lks; Sugar 10" N5°W 10 lks. E.A. Robinson found a stake set by Barker in place of the old stake, and found roots of the old Beech 8" N36°E 25 lks, New Witness: Beech 12" S1°W 42 lks; Lynn 6" N65-1/4°E 41-1/2 lks; DNR Surveyor Carl Roser P.S. 12028 reset corner in a survey dated Dec. 23, 1985; He found center of Sec. 34, T.33N., R.4W. and the South 1/8th corner on the 1/4 line by Robinson and doubled over to reset 1/4 corner position.

*See reverse side for Roser remarks.

B. Description of corner evidence found and/or method applied in restoring or reestablishing corner:


H-13 Found DNR monument, Cedar post and witnesses set by Carl Roser. Reviewed Roser and Robinson surveys and held Roser corner.

H-13---AND IS ACCEPTED AS A CAREFUL AND FAITHFUL REESTABLISHMENT OF THE POSITION OF THE ORIGINAL CORNER.

Charlevoix Co. Surveyor
APPROVED
Signature Mary C. Keendt
Date: 12-3-1993

C. Description of monument for corner and accessories established to perpetuate locating the position of the corner:

H-13 Found DNR monument, Cedar post w/stones
14" Maple East 46.41'
14" Red Pine N70°W 81.18'
12" Maple S50°W 83.34'
13" Maple N82°E 63.00'

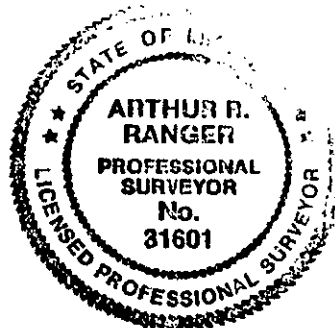

Signed by Arthur R. Ranger Date 01/03/96
Surveyor's Michigan License No. 31601

USE? 003 PAGE 84

A. continued

H-13 Carl Roser remarks per his L.C.R.C. dated 02/07/86:

"Fits E.A. Robinson's entire Sec. 34 survey and section subdivision;
See Chandler book, Pgs. 24-39; Notes in jury room in government building;
Found Schaaf pipe mon. (Set in error - lowered pipe flush w/ground), N70°32'E,
105.4'".

H-13 Restored S 1/4 Cor. Sec. 34 (33-4), N 1/4 Cor. Sec. 3 (32-4) at double distance
and on line across found E.A. Robinson's (1905) center post and South 1/8th
Cor. on N-S 1/4 line of Sec. 34.

SURVEY &
REMONUMENTATION

DEC 16 1996

COMMISSION