

NOV 2 1997

CO

STATE OF MICHIGAN
COUNTY OF CHARLEVOIX
RECEIVED FOR RECORD

97 OCT -9 PM 3:29

LAND CORNER RECORDATION CERTIFICATE
Filing Requirement of Act 74, Mich. P.A. 1970

Charles M. Fisher
REGISTER OF DEEDS

For corners in

CHARLEVOIX (County)	Located In:	Corner Code #
1. Public Land Survey	T <u>33N</u> R <u>4W</u>	<u>J-1</u>
	T _____ R _____	_____
	T _____ R _____	_____
	T _____ R _____	_____
2. Property Controlling in Section	S _____ T _____ R _____	_____
	S _____ T _____ R _____	_____
3. Miscellaneous Property in Sec.	S _____ T _____ R _____	_____
	S _____ T _____ R _____	_____

Register of Deeds Stamp & File Number

4. Lot No. _____, Recorded Plat _____

5. Private Claims _____

I, James E. Evans, in a field survey on Sept 2, 1997 do hereby state that under requirements of P.A. 74, Michigan P.A. of 1970, the corner points mentioned in lines 1 and 2 above were in conformance with regulations and rules therefore as required in the current manual of survey instructions of the United States Department of the Interior, Bureau of Land Management or by a decree of a Court of Law and /or that the corner points mentioned in lines 3, 4 and 5 above were in conformance with the rules of the Michigan Board of Land Surveyors or by a Decree of a Court of Law; established, re-established, monumented, recovered, found as expressed below:

NOTE: Not more than 2 corners, all in the same town and range, may be recorded on this certificate.

	A	B	C	D	E	F	G	H	I	J	K	L
1												
2		6		5		4		3		2		1
3												
4		7		8		9		10		11		12
5												
6		18		17		16		15		14		13
7												
8		19		20		21		22		23		24
9												
10		30		29		28		27		26		25
11												
12		31		32		33		34		35		36
13												

A. Description of original monument and accessories and/or subsequent restoration:

- J-1 North Quarter corner of Section 2 T33N - R4W
 - 1) GLO did not set this corner
 - 2) Mich. Dept of Conservation 7-28-60 By Kenneth Ostling RLS #10068 Set 1" pipe with 4" brass cap 7" R. Pine S81°W 8lks(5.28') 8" R. Pine S42°E 100 1/2 lks (66.33')
 - 3) Orlando Doyle RLS #7319 Jan 1968 Found 1" pipe & Brass Cap Same witnesses as Dept. of Conservation
 - 4) Charlevoix Abstract & Eng. 1-7-75 Found 1" pipe & Brass Cap Same witnesses as Dept. of Cons.

B. Description of corner evidence found and/or method applied in restoring or reestablishing corner:

J-1 North Quarter corner of Section 2 T33N - R4W
 Found 1" pipe 8' North of North edge of gravel road and 5' East of extended center line of CCC road.
 Pipe is 0.15 ft North of township line
 Found both witness trees by Ostling


GLO Comp to K-1 = 2640' CA&E = 2644.64' Meas = 2644.66'
 GLO Comp to I-1 = 2640' Meas = 2645.46'

Charlevoix Co. Surveyor
APPROVED
 Signature Mary C. Fuena
 Date: 10-9-1997

C. Description of monument for corner and accessories established to perpetuate locating the position of the corner:

J-1 North Quarter corner of Section 2 T33N - R4W
 REPLACED 1" PIPE WITH CHARLEVOIX COUNTY MONUMENT

16" RED PINE S70°W	5.19'	SET NAIL & CAP #22431 IN SOUTH SIDE (R=5.28')
18" RED PINE N50°W	56.42'	SET NAIL & CAP #22431 IN SOUTH SIDE
20" RED PINE S89°E	76.62'	SET NAIL & CAP #22431 IN SOUTH SIDE
19" RED PINE S42°E	66.29'	SET NAIL & CAP #22431 IN WEST SIDE (R=66.33')

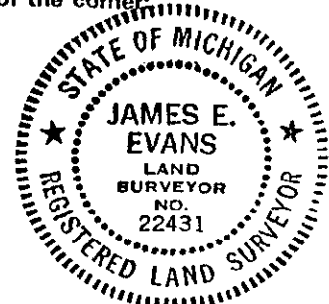

THIS POSITION WAS NOT ESTABLISHED BY ORIGINAL GOVERNMENT SURVEY. THIS MONUMENT IS ACCEPTED AS A CAREFUL AND FAITHFUL DETERMINATION OF THE POSITION OF THE CORNER.

Signed by James E. Evans

Date 10-9-97

Surveyor's Michigan License No. 22431