

**SURVEY &  
REMONUMENTATION**

DEC 1 & 1996

COMMISSION

STATE OF MICHIGAN  
COUNTY OF CHARLEVOIX  
REGISTER OF DEEDS

96 NOV 13 PM 4:50

**LAND CORNER RECORDATION CERTIFICATE**  
Filing Requirement of Act 74, Mich. P.A. 1970

*Charles M. Charles*  
REGISTER OF DEEDS

For corners in

CHARLEVOIX  
(County)

Located In: \_\_\_\_\_ Corner Code #/ \_\_\_\_\_

1. Public Land Survey T 33N R 4W \_\_\_\_\_ J-13  
 T \_\_\_\_\_ R \_\_\_\_\_  
 T \_\_\_\_\_ R \_\_\_\_\_  
 T \_\_\_\_\_ R \_\_\_\_\_

2. Property Controlling S \_\_\_\_\_ T \_\_\_\_\_ R \_\_\_\_\_  
 in Section S T R  
 3. Miscellaneous S \_\_\_\_\_ T \_\_\_\_\_ R \_\_\_\_\_  
 Property in Sec. S T R

4. Lot No. \_\_\_\_\_, Recorded Plat \_\_\_\_\_

5. Private Claims \_\_\_\_\_

Register of Deeds Stamp & File Number

I, ARTHUR R. RANGER, in a field survey on SEPT. 11, 19 93, do hereby certify that under requirements of P.A. 74, Michigan P.A. of 1970, the corner points mentioned in lines 1 and 2 above were in conformance with regulations and rules therefore as required in the current manual of survey instructions of the United States Department of the Interior, Bureau of Land Management or by a decree of a Court of Law and/or that the corner points mentioned in lines 3, 4 and 5 above were in conformance with the rules of the Michigan Board of Land Surveyors or by a Decree of a Court of Law; established, re-established, monumented, re-monumented, recovered, found as expressed below:

**NOTE: Not more than 4 corners, all in the same town and range, may be recorded on this certificate.**

	A	B	C	D	E	F	G	H	I	J	K	L
2	6		5		4		3		2		1	
3												
4	7		8		9		10		11		12	
5												
6	18		17		16		15		14		13	
7												
8	19		20		21		22		23		24	
9												
10	30		29		28		27		26		25	
11												
12	31		32		33		34		35		36	
13												

A. Description of original monument and accessories and/or subsequent restoration:

J-13 GLO - Set Qr. post - Beech 14" N42°W 20 lks; Sugar 12" N28°E 19 lks; E.K. Robinson reset Qr. Section post in a survey dated 1881- Witness: Beech 14" N42°W 20 lks; Sugar 12" N28°E 19 lks; Wayne Boss P.S. 20703 reset the corner with a 1/2" iron rod in a survey dated Nov. 28, 1973- Witness: Spike in tree S36°E 16.90'; Spike in tree S5°E 43.82'; Spike in tree N60°W 41.56'

B. Description of corner evidence found and/or method applied in restoring or reestablishing corner:


J-13 Found 1/2" rod and witnesses; Boss corner falls 8.70' South & 14.23' East of the true position of corner based on establishing its position halfway and on line between section corners to the East and West. Set Harrison monument halfway and on line between section corners at the corner's true position. (See L.C.R.C. for I-13 by Art Ranger; The corner's position shifted because of the corrected position of I-13).

J-13---AND IS ACCEPTED AS A CAREFUL AND FAITHFUL REESTABLISHMENT OF THE POSITION OF THE ORIGINAL CORNER.

C. Description of monument for corner and accessories established to perpetuate locating the position of the corner:

J-13 Set Harrison monument  
 Witness:  
 12" Maple S50°W 25.34'  
 14" Maple S6°E 20.61'  
 18" Maple S44°E 32.72'  
 12" Ash S79°E 20.40'  
 1/2" Rod S50°E 16.68'

Charlevoix Co. Surveyor  
 APPROVED  
 Signature *Mary C. Feindel*  
 Date: 12-3-93

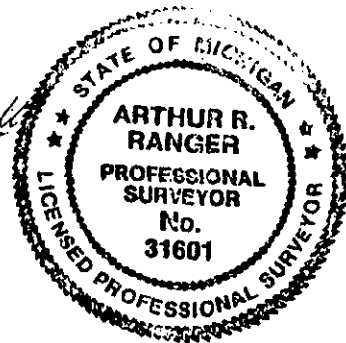

Signed by *Arthur R. Ranger* Date 01/03/96  
 Surveyor's Michigan License No. 31601