

SURVEY & REMONUMENTATION

FEB 04 1999

SECTION

LAND CORNER RECORDATION CERTIFICATE
Filing Requirement of Act 74, Mich. P.A. 1970

STATE OF MICHIGAN
COUNTY OF CHARLEVOIX
RECEIVED FOR RECORD

98 NOV 13 PM 3:53

Charles M. Probert
REGISTER OF DEEDS
CLERK OF DISTRICT

For corners in
CHANDLER TWP

CHARLEVOIX
(County)

Located In:

Corner Code #

- | | | |
|------------------------------------|---------------------------|------------|
| 1. Public Land Survey | T <u>33N</u> R <u>4</u> W | <u>L-1</u> |
| | T _____ R _____ | _____ |
| | T _____ R _____ | _____ |
| | T _____ R _____ | _____ |
| 2. Property Controlling in Section | S _____ T _____ R _____ | _____ |
| | S _____ T _____ R _____ | _____ |
| 3. Miscellaneous Property in Sec. | S _____ T _____ R _____ | _____ |
| | S _____ T _____ R _____ | _____ |

Register of Deeds Stamp & File Number

4. Lot No. _____, Recorded Plat _____

5. Private Claims _____

I, JAMES E. EVANS, in a field survey on OCTOBER 7, 1998 do hereby state that under requirements of P.A. 74, Michigan P.A. of 1970, the corner points mentioned in lines 1 and 2 above were in conformance with regulations and rules therefore as required in the current manual of survey instructions of the United States Department of the Interior, Bureau of Land Management or by a decree of a Court of Law and /or that the corner points mentioned in lines 3, 4 and 5 above were in conformance with the rules of the Michigan Board of Land Surveyors or by a Decree of a Court of Law; established, re-established, monumented, recovered, found as expressed below:

NOTE: Not more than 2 corners, all in the same town and range, may be recorded on this certificate.

A. Description of original monument and accessories and/or subsequent restoration:

L-1 NORTH QUARTER CORNER SECTION 1 T33N-R4W
GENERAL LAND OFFICE
Set 1/4 Sec. post
Maple 6" N56°E 21 Links (13.86')
Maple 14" N40°W 44 Links (29.04')
May 22, 1840
By: John Mullett D.S.

	A	B	C	D	E	F	G	H	I	J	K	L	M
1													
2	6		5		4		3		2		1		
3													
4	7		8		9		10		11		12		
5													
6	18		17		16		15		14		13		
7													
8	19		20		21		22		23		24		
9													
10	30		29		28		27		26		25		
11													
12	31		32		33		34		35		36		
13													

B. Description of corner evidence found and/or method applied in restoring or reestablishing corner:

L-1 NORTH QUARTER CORNER SECTION 1 T33N-R4W

Found no corner or evidence of original corner.

Distance to corner M-1 Measured 2588.26' (DNR = 2574.00')
Distance to corner K-1 Measured 2588.26' (DNR = 2638.68')

Charlevoix Co. Surveyor
APPROVED
Signature Mary C. Fennell
Date: 11/12/98

C. Description of monument for corner and accessories established to perpetuate locating the position of the corner:

L-1 NORTH QUARTER CORNER SECTION 1 T33N-R4W


Set cast iron Charlevoix County monument half way on line between M-1 and K-1. Corner falls on the South edge of North County Line Road.

WITNESSES: 7" Maple S07°W 12.26' Set nail and cap in South side
12" Jack Pine S46°E 76.14' Set nail and cap in NW side
Corner fence post N630E 68.67' Set nail and cap in South side
10" Cherry N89°W 136.74' Set nail and cap in North side
Buried cable sign S89°W 103.30'

And is accepted as the best available evidence of the position of the original corner.

Signed by *James E. Evans*
Surveyor's Michigan License No. 22431

Date 11-12-98

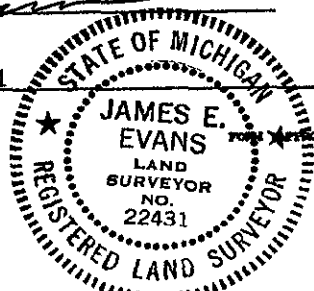

APPROVED BY MICHIGAN STATE BOARD OF PROFESSIONAL SURVEYORS, JAN. 28, 1971
REVISED MAY 14, 1975
REVISED JAN., 1983
REVISED OCT., 1995