

**SURVEY &  
REMONUMENTATION**

DEC 16 1996

COMMISSION

STATE OF MICHIGAN  
COUNTY OF CHARLEVOIX  
REGISTERED DEEDS

96 NOV 13 PM 4:51

**LAND CORNER RECORDATION CERTIFICATE**  
Filing Requirement of Act 74, Mich. P.A. 1970

*Charlene M. [Signature]*  
REGISTER OF DEEDS

For corners in

... CHARLEVOIX (County) Located In: Corner Code :#

1. Public Land Survey	T	33N	R	4W	K-13
	T	33N	R	4W	L-13
	T		R		
	T		R		
2. Property Controlling in Section	S		T	R	
	S		T	R	
3. Miscellaneous Property in Sec.	S		T	R	
	S		T	R	

Register of Deeds Stamp & File Number

4. Lot No. \_\_\_\_\_, Recorded Plat \_\_\_\_\_  
5. Private Claims \_\_\_\_\_

I, ARTHUR R. RANGER, in a field survey on SEPT 11, 19 93, do hereby certify that under requirements of P.A. 74, Michigan P.A. of 1970, the corner points mentioned in lines 1 and 2 above were in conformance with regulations and rules therefore as required in the current manual of survey instructions of the United States Department of the Interior, Bureau of Land Management or by a decree of a Court of Law and/or that the corner points mentioned in lines 3, 4 and 5 above were in conformance with the rules of the Michigan Board of Land Surveyors or by a Decree of a Court of Law; established, re-established, monumented, re-monumented, recovered, found as expressed below:

**NOTE: Not more than 4 corners, all in the same town and range, may be recorded on this certificate.**

A. Description of original monument and accessories and/or subsequent restoration:

K-13 GLO - Set post - Beech 10" N52°E 13 lks; Sugar 16" N29°W 14 lks; E.K. Robinson, County Surveyor set post in a survey dated 1881- Witness: Sugar 24" S34°W 34.5 lks; Beech 10" N52°E 13 lks; Sugar 16" N 29°W 14 lks; Elm 2" N43-1/2°E 39 lks.

L-13 - GLO - Set post - Beech 14" N64°E 30 lks; Beech 10" N80°W 18 lks; E.K. Robinson, County Surveyor reset Quarter corner in a survey in 1881 - Witness: Sugar 4" N38°E 16 lks; Sugar 10" N80°W 18 lks.

B. Description of corner evidence found and/or method applied in restoring or reestablishing corner:

K-13 - Found large 2" iron pipe 4' below grade in a road intersection; origin of corner unknown; Fits occupation N., S., E. & W., and is being used by others in surveys; Held 2" iron pipe; Raised corner up with a Harrison monument.

L-13 - Found 1/2" rod used by others in surveys according to George J. Avent Jr., P.S. 16034. (Note: Found 1/2" rod is 0.31' North & 2.45' West of a true split and on line). Held 1/2" iron rod - origin unknown.

K-13---AND IS ACCEPTED AS THE BEST AVAILABLE EVIDENCE OF THE POSITION OF THE ORIGINAL CORNER.


L-13---AND IS ACCEPTED AS A CAREFUL AND FAITHFUL REESTABLISHMENT OF THE POSITION OF THE ORIGINAL CORNER.

C. Description of monument for corner and accessories established to perpetuate locating the position of the corner:

K-13 Set Harrison monument over 2" iron pipe Witness: 9" Maple N44°W 21.03' 9" Ironwood S84°W 52.91' 4" Ironwood S50°W 21.31' 1/2" Rod South 33.27' 20" Maple S8°E 14.37'	L-13 Replaced 1/2" Rod w/Harrison Monument Witness: 10" Maple N24°W 5.65' 5" Maple N44°E 7.00' 6" Beech N82°E 13.71' 9" Maple S12°W 6.59'
---	--

Charlevoix Co. Surveyor  
**APPROVED**

Signature Mary C. Fennell  
Date: 10-3-93

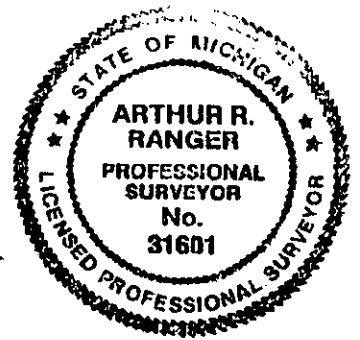

Signed by Arthur R. Ranger Date 01/03/96

Surveyor's Michigan License No. 31601