

SURVEY & REMONUMENTATION

FEB 04 1999

STATE OF MICHIGAN
COUNTY OF CHARLEVOIX
RECEIVED FOR RECORD

98 NOV 13 PM 3:58

SECTION

LAND CORNER RECORDATION CERTIFICATE
Filing Requirement of Act 74, Mich. P.A. 1970

Charles M. Crocker
REGISTER OF DEEDS

For corners in
HANDLER TWP
CHARLEVOIX
(County)

Located In: Corner Code #

1. Public Land Survey T 33N R 4 W M-5
T _____ R _____
T _____ R _____
T _____ R _____
2. Property Controlling S _____ T _____ R _____
in Section S _____ T _____ R _____
3. Miscellaneous S _____ T _____ R _____
Property in Sec. S _____ T _____ R _____

Register of Deeds Stamp & File Number

4. Lot No. _____, Recorded Plat _____
5. Private Claims _____

I, JAMES E. EVANS, in a field survey on OCTOBER 5, 1998 do hereby state that under requirements of P.A. 74, Michigan P.A. of 1970, the corner points mentioned in lines 1 and 2 above were in conformance with regulations and rules therefore as required in the current manual of survey instructions of the United States Department of the Interior, Bureau of Land Management or by a decree of a Court of Law and for that the corner points mentioned in lines 3, 4 and 5 above were in conformance with the rules of the Michigan Board of Land Surveyors or by a Decree of a Court of Law; established, re-established, monumented, recovered, found as expressed below:

	A	B	C	D	E	F	G	H	I	J	K	L	M
1													
2	6		5		4		3		2		1		
3													
4	7		8		9		10		11		12		
5													
6	18		17		16		15		14		13		
7													
8	19		20		21		22		23		24		
9													
10	30		29		28		27		26		25		
11													
12	31		32		33		34		35		36		
13													

NOTE: Not more than 2 corners, all in the same town and range, may be recorded on this certificate.

A. Description of original monument and accessories and/or subsequent restoration:
M-5 CORNER COMMON TO SEC 12 & 13 T33N-R4W and SEC 7 & 18 T33N-R3W
GENERAL LAND OFFICE
Set corner post
Maple 14" N85°W 5 Links (3.3')
Lynwood 24" S85°E 10 Links (6.6')
May 22, 1840
By: John Mullett D.S.

B. Description of corner evidence found and/or method applied in restoring or reestablishing corner:
M-5 CORNER COMMON TO SEC 12 & 13 T33N-R4W and SEC 7 & 18 T33N-R3W
Found no corner or evidence of original corner.
No occupation available.

Charlevoix Co. Surveyor
APPROVED
Signature Mary C. Fennell
Date: NOV. 12, 1998

Distance to corner M-4 Measured 2657.20' (GLO = 2640.0')
Distance to corner M-6 Measured 2657.20' (GLO = 2640.0')

C. Description of monument for corner and accessories established to perpetuate locating the position of the corner:
M-5 CORNER COMMON TO SEC 12 & 13 T33N-R4W and SEC 7 & 18 T33N-R3W
Set cast iron Charlevoix County monument half way on line between M-4 and M-6.


WITNESSES: 12" Basswood S33°E 6.60' Set nail and cap in East side (old blaze)
14" Maple N73°E 33.91' Set nail and cap in North side (old blaze)
21" Basswood N05°W 36.59' Set nail and cap in East side (old blaze)
9" Maple N58°W 34.05 Set nail and cap in North side

And is accepted as the best available evidence of the position of the original corner.

Signed by James E. Evans

Date 11-12-98

Surveyor's Michigan License No. 22431

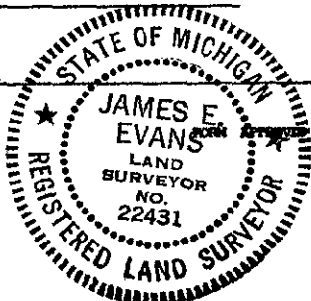

MICHIGAN STATE BOARD OF PROFESSIONAL SURVEYORS, JAN. 28, 1971
REVISED MAY 18, 1975
REVISED JUN., 1983
REVISED OCT., 1995

003 205