

**SURVEY &  
REMONUMENTATION**

OCT 18 1996

COMMISSION

LAND CORNER RECORDATION CERTIFICATE  
Filing Requirement of Act 74, Mich. P.A. 1970

STATE OF MICHIGAN  
COUNTY OF CHARLEVOIX  
RECEIVED FOR RECORD

96 OCT 14 AM 10:32

*Charles M. Craker*  
REGISTER OF DEEDS

For corners in  
Charlevoix &  
Cheboygan  
(County)

Located In: Corner Code #

- |                                    |                   |                |
|------------------------------------|-------------------|----------------|
| 1. Public Land Survey              | T33N R4W          | M-8            |
|                                    | T33N R3W          | A-8            |
|                                    | T ___ R ___       |                |
|                                    | T ___ R ___       |                |
| 2. Property Controlling in Section | S ___ T ___ R ___ | <i>Sec. #1</i> |
|                                    | S ___ T ___ R ___ |                |
| 3. Miscellaneous Property in Sec.  | S ___ T ___ R ___ |                |
|                                    | S ___ T ___ R ___ |                |

Register of Deeds Stamp & File Number

4. Lot No. \_\_\_\_\_, Recorded Plat \_\_\_\_\_  
5. Private Claims \_\_\_\_\_

I, James E. Evans, in a field survey on Oct. 2, 1996 do hereby state that under requirements of P.A. 74, Michigan P.A. of 1970, the corner points mentioned in lines 1 and 2 above were in conformance with regulations and rules therefore as required in the current manual of survey instructions of the United States Department of the Interior, Bureau of Land Management or by a decree of a Court of Law and/or that the corner points mentioned in lines 3, 4 and 5 above were in conformance with the rules of the Michigan Board of Land Surveyors or by a Decree of a Court of Law; established, re-established, monumented, recovered, found as expressed below:

	A	B	C	D	E	F	G	H	I	J	K	L	M
1													
2		6		5		4		3		2		1	
3													
4		7		8		9		10		11		12	
5													
6		18		17		16		15		14		13	
7													
8		19		20		21		22		23		24	
9													
10		30		29		28		27		26		25	
11													
12		31		32		33		34		35		36	
13													

NOTE: Not more than 2 corners, all in the same town and range, may be recorded on this certificate.

A. Description of original monument and accessories and/or subsequent restoration:

M-8 QUARTER CORNER COMMON TO SEC 24, T33N-R4W and SEC 19, T33N-R3W

GLO: Set quarter post  
Sugar S31°W 29 lks (19.14')  
10" Beech N 6°E 31 lks (20.46')  
by John Mullett in 1840

5-19-1887  
E.K. Robinson survey notes  
Found Sec. corner  
Same witness as GLO

June 1970 Survey by Charlevoix  
Abstract & Engineering  
Computed corner at mid point between Sec coners

B. Description of corner evidence found and/or method applied in restoring or reestablishing corner:

Found no evidence of GLO post or witnesses. Found 3/4" pipe 12" above ground.  
Pipe is 25 ft East and 22 ft South of a split of the section corners.


Computed corner on split between M-7 and M-9 at prorated distance from Center Quarter corner as shown by 1887 E.K. Robinson survey.  
Computed corner falls 4.4ft East of true line between M-7 and M-9.

GLO to M-7 = 2640'	GLO to M-9 = 2640'
CA&E 1970 = 2660.27	CA&E 1970 = 2660.27'
Mean = 2660.35'	Mean = 2660.35'

C. Description of monument for corner and accessories established to perpetuate locating the position of the corner:  
Removed old pipe and set Charlevoix County cast iron monument at computed position.

7" Maple N53°E 14.04' set nail & cap #22431 in SE side  
12" Maple S55°E 35.49' set nail & cap #22431 in NE side  
17" Maple S87°W 16.45' set nail & cap #22431 in South side  
8" Maple N23°W 23.80' set nail & cap #22341 in East side

Charlevoix Co. Surveyor  
**APPROVED**  
Signature May C. Fendell  
Date: 10-10-96

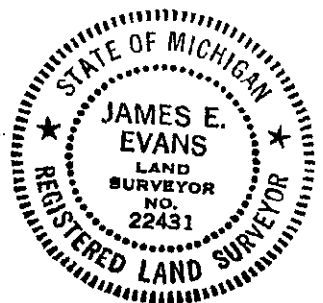

And is accepted as a careful and faithful reestablishment of the position of the original corner.

Signed by: *James E. Evans*  
Surveyor's Michigan License No. 22431

Date: 10-10-96