

**SURVEY &
REMONUMENTATION**

OCT 18 1996

COMMISSION

LAND CORNER RECORDATION CERTIFICATE
Filing Requirement of Act 74, Mich. P.A. 1970

STATE OF MICHIGAN
COUNTY OF CHARLEVOIX
RECEIVED FOR RECORD

96 OCT 14 AM 10:34

Charlene M. Barber
REGISTER OF DEEDS

For corners in,
Charlevoix &
Cheboygan
(County)

Located In: Corner Code #

1. Public Land Survey	T33N R4W	<u>M-10</u>
	T33N R3W	<u>A-10</u>
	T___ R___	_____
	T___ R___	_____
2. Property Controlling in Section	S___ T___ R___	<u>Seg #1</u>
	S___ T___ R___	_____
3. Miscellaneous Property In Sec.	S___ T___ R___	_____
	S___ T___ R___	_____

Register of Deeds Stamp & File Number

4. Lot No. _____, Recorded Plat _____
5. Private Claims _____

I, James E. Evans, in a field survey on Oct. 2, 1996 do hereby state that under requirements of P.A. 74, Michigan P.A. of 1970, the corner points mentioned in lines 1 and 2 above were in conformance with regulations and rules therefore as required in the current manual of survey instructions of the United States Department of the Interior, Bureau of Land Management or by a decree of a Court of Law and/or that the corner points mentioned in lines 3, 4 and 5 above were in conformance with the rules of the Michigan Board of Land Surveyors or by a Decree of a Court of Law; established, re-established, monumented, recovered, found as expressed below:

NOTE: Not more than 2 corners, all in the same town and range, may be recorded on this certificate.

	A	B	C	D	E	F	G	H	I	J	K	L	M
1													
2		6		5		4		3		2		1	
3													
4		7		8		9		10		11		12	
5													
6		18		17		16		15		14		13	
7													
8		19		20		21		22		23		24	
9													
10		30		29		28		27		26		25	
11													
12		31		32		33		34		35		36	
13													

A. Description of original monument and accessories and/or subsequent restoration:

M-10 QUARTER CORNER COMMON TO SEC 25 T33N-R4W and SEC 30 T33N-R3W

GLO: Set quarter post
10" Beech N32°W 31 lks (20.46')
8" Beech S21°E 21 lks (13.86')
by John Mullett in 1840

B. Description of corner evidence found and/or method applied in restoring or reestablishing corner:

Found no evidence of GLO post or witnesses. No evidence of occupation lines or previous surveys.

Computed corner by single proration distance between corners M-9 and M-13.

GLO to M-9 = 2640'	GLO to M-11 = 2640'
Meas = 2643.37'	Meas = 2643.37'


Charlevoix Co. Surveyor
APPROVED
Signature Mary C. Ferrell
Date: 10/10/96

C. Description of monument for corner and accessories established to perpetuate locating the position of the corner:

Set Charlevoix County cast iron monument at computed position.

12" Maple N19E 24.21' set nail & cap #22431 in West side
5" Maple S80°E 6.57' set nail & cap #22431 in South side
10" Maple S02°W 14.59' set nail & cap #22431 in West side
20" Maple N78°W 8.78' set nail & cap #22341 in South side

And is accepted as the best available evidence of the position of the original corner.

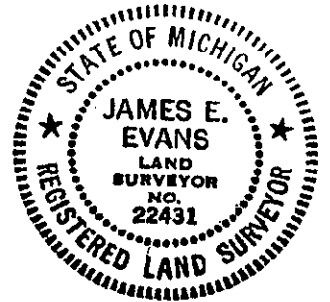

Signed by [Signature]
Surveyor's Michigan License No. 22431

Date 10/10/96