

**SURVEY &
REMONUMENTATION**

OCT 18 1996

LAND CORNER RECORDATION CERTIFICATE
Filing Requirement of Act 74, Mich. P.A. 1970

STATE OF MICHIGAN
COUNTY OF CHARLEVOIX
RECEIVED FOR RECORD

96 OCT 14 AM 10:35

For corners in
Charlevoix &
Cheboygan
COMMISSION
(County)

Charles M. Robinson
REGISTER OF DEEDS

Located In: _____ Corner Code # _____

1. Public Land Survey T33N R4W M-11
T33N R3W A-11
T _____ R _____
T _____ R _____
2. Property Controlling S _____ T _____ R _____
in Section S _____ T _____ R _____
3. Miscellaneous S _____ T _____ R _____
Property in Sec. S _____ T _____ R _____

Register of Deeds Stamp & File Number

4. Lot No. _____, Recorded Plat _____
5. Private Claims _____

I, James E. Evans, in a field survey on Oct. 2, 19 96 do hereby state that under requirements of P.A. 74, Michigan P.A. of 1970, the corner points mentioned in lines 1 and 2 above were in conformance with regulations and rules therefore as required in the current manual of survey instructions of the United States Department of the Interior, Bureau of Land Management or by a decree of a Court of Law and for that the corner points mentioned in lines 3, 4 and 5 above were in conformance with the rules of the Michigan Board of Land Surveyors or by a Decree of a Court of Law; established, re-established, monumented, recovered, found as expressed below:

A	B	C	D	E	F	G	H	I	J	K	L	M
1												
2	6		5		4		3		2		1	
3												
4	7		8		9		10		11		12	
5												
6	18		17		16		15		14		13	
7												
8	19		20		21		22		23		24	
9												
10	30		29		28		27		26		25	
11												
12	31		32		33		34		35		36	
13												

NOTE: Not more than 2 corners, all in the same town and range, may be recorded on this certificate.


A. Description of original monument and accessories and/or subsequent restoration:
M-11 CORNER COMMON TO SEC 25 & 36, T33N-R4W and SEC 30 & 31, T33N-R3W
GLO: Set post 5-13-1909
14" Hemlock N35°W 20 lks (13.20') E.A. Robinson survey
10" Hemlock S17°E 14 lks (9.24') Shows section corner
by John Mullett in 1840 No witnesses or identification

B. Description of corner evidence found and/or method applied in restoring or reestablishing corner:
Found no evidence of GLO post or witnesses. No evidence of occupation lines or previous surveys.
Computed corner by single proration distance between corners M-9 and M-13.

GLO to M-9 = 2640' GLO to M-11 = 2640'
Meas = 2643.37' Meas = 2643.37'

Charlevoix Co. Surveyor
APPROVED
Signature May C. Penrott
Date: 10-10-96

C. Description of monument for corner and accessories established to perpetuate locating the position of the corner:
Set Charlevoix County cast iron monument at computed position.
Corner is ± 40 ft West of top of hill and ± 40 ft South of trail.
2" Ironwood N20°E 17.64' set nail & cap #22431 in East side
7" Maple N 7°E 29.65' set nail & cap #22431 in NE side
7" Maple S30°W 5.78' set nail & cap #22431 in SE side
5" Maple N28°W 22.63' set nail & cap #22341 in SW side

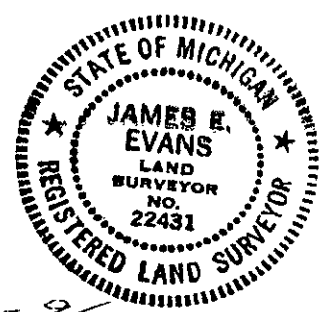

And is accepted as the best available evidence of the position of the original corner.

Signed by James E. Evans
Surveyor's Michigan License No. 22431

Date 10-10-96