

LAND CORNER RECORDATION CERTIFICATE

Filing Requirement of Act 74, Mich. PA 1970

For Corners In:
Charlevoix Located In _____ Corner Code # _____
 (County)

1. Public Land Survey		T	<u>33N</u>	R	<u>4W</u>	<u>I-7</u>
		T	<u>33N</u>	R	<u>4w</u>	<u>J-8</u>
2. Property Controlling in Section	S	T		R		
	S	T		R		
3. Miscellaneous Property in Section	S	T		R		
	S	T		R		


4. Lot No: _____ Recorded Plat: _____

5. Private Claims: _____

I, Carl T. Kiiskila, in a field survey on October, 1999 do hereby state that under requirements of PA 74, Michigan PA of 1970, the corner points mentioned in lines 1 and 2 above were in conformance with regulations and rules therefore as required in the current manual of survey instructions of the United States Department of the Interior, Bureau of Land Management or by a decree of a Court of Law and/or that the corner points mentioned in lines 3, 4 and 5 above were in conformance with the rules of the Michigan Board of Land Surveyors or by a Decree of a Court of Law; established, re-established, monumented, recovered, found as expressed below:

NOTE: Not more than 2 corners, all in the same town and range, may be recorded on this certificate.

Register of Deeds Stamp & File Number

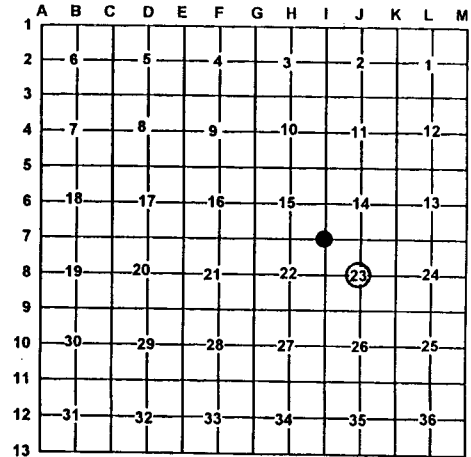

A. Description of original monument and accessories and/or subsequent restoration:

I-7 G.L.O.-Charles W. Cathcart D.S. -Oct. 1841.
 Set post corner to sections 14,15,22, and 23
 Wit: Hemlock 8" N55°E 25 Links
 Lynn 12" S70°W 22 Links

J-8 This corner position was not established during the original government survey.

B. Description of corner evidence found and/or method applies in restoring or re-establishing corner:

I-7 Re-established the northwest corner of section 23 by double proportionate measurement between corners one mile to the North, South, East and West

J-8 Established the center of section 23 at the intersection of the North-South and East West quarter lines.

C. Description of monument for corner and accessories established to perpetuate locating the position of the corner:

I-7 Set 1"X32" Iron Pipe with Aluminum DNR cap.
 Wit: 5" Maple S62°E 20.36'
 8" Maple S22°E 15.62'
 7" Maple S46°W 11.13'
 7" Maple N28°W 20.72'
 Carsonite post North 1'

J-8 Set 5/8"X32" Rerod with cap.
 Wit: 10" Basswood N70°W 4.49'
 12" Maple S32°E 15.12'
 12" Maple S24°W 27.83'
 7" Basswood N85°W 13.42'
 Carsonite post North 1'

Signed by: Carl T. Kiiskila
 Surveyor's Michigan License No.: 33981

Date: 1-26-00

