

LAND CORNER RECORDATION CERTIFICATE

Filing Requirement of Act 74, Mich. PA 1970

For Corners In: Charlevoix (County)	Located In	Corner Code #
1. Public Land Survey	T <u>33N</u> R <u>4W</u>	K-9
	T <u>33N</u> R <u>4W</u>	K-7
2. Property Controlling in Section	S _____ T _____ R _____	_____
	S _____ T _____ R _____	_____
3. Miscellaneous Property in Section	S _____ T _____ R _____	_____
	S _____ T _____ R _____	_____


Register of Deeds Stamp & File Number

4. Lot No: _____ Recorded Plat: _____

5. Private Claims: _____

I, Carl T. Kiiskila, in a field survey on October, 1999 do hereby state that under requirements of PA 74, Michigan PA of 1970, the corner points mentioned in lines 1 and 2 above were in conformance with regulations and rules therefore as required in the current manual of survey instructions of the United States Department of the Interior, Bureau of Land Management or by a decree of a Court of Law and/or that the corner points mentioned in lines 3, 4 and 5 above were in conformance with the rules of the Michigan Board of Land Surveyors or by a Decree of a Court of Law; established, re-established, monumented, recovered, found as expressed below:

NOTE: Not more than 2 corners, all in the same town and range, may be recorded on this certificate.

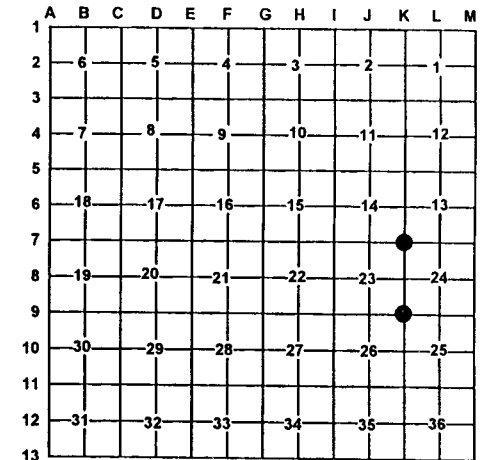

A. Description of original monument and accessories and/or subsequent restoration:

K-9 G.L.O. – Charles W. Cathcart D.S. 1841.
Set post corner to sections 23,24,25, and 26.
Wit: Sugar 24" S85°W 9 Links
Sugar 6" N82°E 13 Links

K-7 G.L.O.-Charles W. Cathcart D.S. 1841
Set post corner to sections 13,14,23, and 24.
Wit: Sugar 18" N50°W 18 Links
Beech 6" S75°W 9 Links

From county surveyor's records liber 1, page 229, May 19, 1887, EK Robinson, County surveyor, found post corner sections 23,24, 25, and 26.
Wit: Old-Sugar 24" S85°W 9 links
New- Sugar 28" S78°E 82.5 links

From county surveyors "Field book Chandler" May 16, 1908, reset corner 13, 14, 23, and 24. Gun barrel under stone on side hill center road intersection, Sugar Shade S21°E 36.5' EK Robinson.

C.F. Roser PS #12028 September 1982, found a gun barrel while doing a survey in the area.

From county surveyor's field book #1, page 25, May 15, 1908, 1" iron pipe 14" long under stone "X" on top.
Wit: Apple Tree 6" N24.5W 133.5 links

C.F. Roser PS# 12028 September 1982. Found a 1" pipe under a 8" rock in road intersection.

B. Description of corner evidence found and/or method applies in restoring or re-establishing corner:

K-9 Found 1" iron pipe fitting C.F. Roser September 1982 survey.

K-7 Found 3/4" octagon gun barrel stock. Bent by road grader replaced with 5/8" x32" rerod with P.S. cap.

C. Description of monument for corner and accessories established to perpetuate locating the position of the corner:

K-9 1" Iron pipe
Wit: 20" Apple S43°E 52.80'
Stop sign post S78°W 41.34'
Corner fence post N48°W 43.16'
Telephone pedestal N56°E 38.71'

K-7 Set 5/8"X32" rerod with P.S. cap #33981
Wit: 8" Twin Maple N45°E 42.84'
3" Maple N68°E 20.78'
Power Pole S25°E 36.09'
Corner fence post N84°W 36.43'

Signed by: Carl T. Kiiskila
Surveyor's Michigan License No.: 33981

Date: 1-26-00

