

LAND CORNER RECORDATION CERTIFICATE

Filing Requirement of Act 74, Mich. PA 1970

For Corners In: Charlevoix (County)	Located In	Corner Code #
1. Public Land Survey	T <u>33N</u> R <u>4W</u>	<u>I-5</u>
	T <u>33N</u> R <u>4W</u>	<u>I-8</u>
2. Property Controlling in Section	S _____ T _____ R _____	_____
	S _____ T _____ R _____	_____
3. Miscellaneous Property in Section	S _____ T _____ R _____	_____
	S _____ T _____ R _____	_____


4. Lot No: _____ Recorded Plat: _____

5. Private Claims: _____

I, Carl T. Kiiskila, in a field survey on October, 1999 do hereby state that under requirements of PA 74, Michigan PA of 1970, the corner points mentioned in lines 1 and 2 above were in conformance with regulations and rules therefore as required in the current manual of survey instructions of the United States Department of the Interior, Bureau of Land Management or by a decree of a Court of Law and/or that the corner points mentioned in lines 3, 4 and 5 above were in conformance with the rules of the Michigan Board of Land Surveyors or by a Decree of a Court of Law, established, re-established, monumented, recovered, found as expressed below:

NOTE: Not more than 2 corners, all in the same town and range, may be recorded on this certificate.

Register of Deeds Stamp & File Number

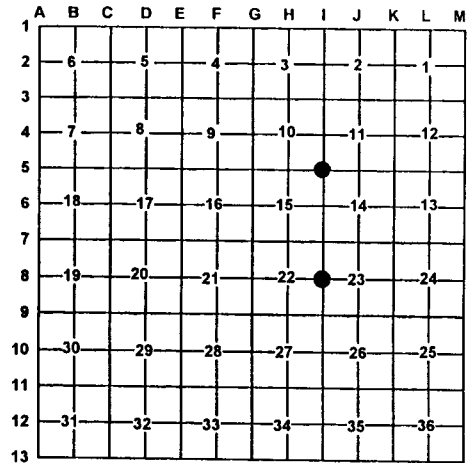

A. Description of original monument and accessories and/or subsequent restoration:

I-5 G.L.O.- Charles W. Cathcart D.S. Oct. 1841.
Set post corner to sections 10,11,14, and 15
Wit: Sugar 4" S70°E 7 Links

I-8 G.L.O.- Charles W. Cathart D.S. Oct. 1841.
Set quarter section post
Wit: Sugar 4" N70°E 10 Links
Sugar 4" S60°W 10 Links

O. Doyle RLS #7319, 1968 survey shows 1" pipe for corner.

J. Ferguson L.S. #24595 certificate of survey shows 1" pipe for corner.

Wit: 4" Maple N58°W 6.5'
10" Maple West 94.5'
6" Maple S78°W 9.5'
6" Maple S80°E 16.7'

B. Description of corner evidence found and/or method applies in restoring or re-establishing corner:

I-5 Found 1" Iron Pipe fitting John Ferguson L.S. 24595 witnesses and O. Doyle 1968 survey in the area. It is believed O. Doyle witnesses for this corner were erroneously recorded.

I-8 Re-established the west quarter corner of section 23 by single proportionate measurement between I-7 and I-9.

C. Description of monument for corner and accessories established to perpetuate locating the position of the corner:

I-5 1" Iron pipe
Wit: *12" Maple N84°W 9.94'
*5" Maple N47°W 6.63'
*6" Maple S57°W 9.82'
*10" Maple S56°E 17.21'

I-8 Set 1"X32" iron pipe with aluminum DNR cap.
Wit: 18" Maple N83°E 16.59'
4" Maple S21°E 21.99'
6" Maple S36°W 33.68'
8" Maple N59°W 38.35'
Carsonite post North 1'

* Old witnesses by J. Ferguson

Signed by: Carl T. Kiiskila
Surveyor's Michigan License No.: 33981

Date: 1-26-00

