

LAND CORNER RECORDATION CERTIFICATE

Filing Requirement of Act 74, Mich. PA 1970

For Corners In: Charlevoix (County)	Located In	Corner Code #
1. Public Land Survey	T _____ R _____	_____
	T _____ R _____	_____
2. Property Controlling in Section	S <u>27</u> T <u>33N</u> R <u>4W</u>	<u>7</u>
	S <u>27</u> T <u>33N</u> R <u>4W</u>	<u>9</u>
3. Miscellaneous Property in Section	S _____ T _____ R _____	_____
	S _____ T _____ R _____	_____


Register of Deeds Stamp & File Number

4. Lot No: _____ Recorded Plat: _____

5. Private Claims: _____

I, Carl T. Kiiskila, in a field survey on August, 2000 do hereby state that under requirements of PA 74, Michigan PA of 1970, the corner points mentioned in lines 1 and 2 above were in conformance with regulations and rules therefore as required in the current manual of survey instructions of the United States Department of the Interior, Bureau of Land Management or by a decree of a Court of Law and/or that the corner points mentioned in lines 3, 4 and 5 above were in conformance with the rules of the Michigan Board of Land Surveyors or by a Decree of a Court of Law; established, re-established, monumented, recovered, found as expressed below:

NOTE: Not more than 2 corners, all in the same town and range, may be recorded on this certificate.

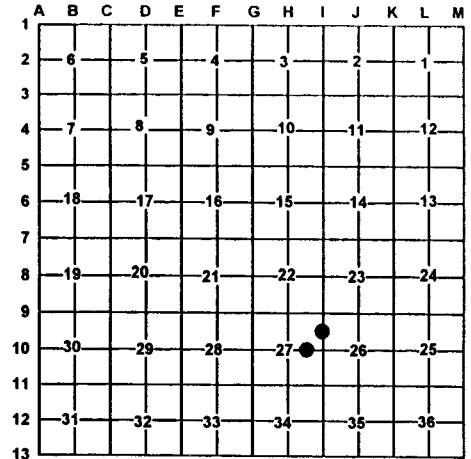

A. Description of original monument and accessories and/or subsequent restoration:

7-This corner position was not established during the original government survey. 9-This corner position was not established during the original government survey.

B. Description of corner evidence found and/or method applies in restoring or re-establishing corner:

7- Established the Northeast corner of the Southeast quarter of the Northeast quarter of section 27 by B.L.M. instruction for the subdivision of a section. 9- Established the Southwest corner of the Southeast quarter of the Northeast quarter of section 27 by B.L.M. instructions for the subdivision of a section.

C. Description of monument for corner and accessories established to perpetuate locating the position of the corner:

7- 5/8"X32" rered with P.S. cap #33981	9- 5/8" X 32" rered with P.S. cap #33981
Wit: 6" Shagbark Hickory S63°E 33.12'	Wit: 4" Beech N22°E 14.87'
6" Elm S23°E 38.62'	12" Maple S74°E 11.89'
20" Maple S48°W 53.22'	10" Basswood S17°W 16.76'
20" maple N70°W 47.88'	14" Maple West 6.59'
Carsonite post West 33±	Carsonite post North 1±

Signed by: Carl T Kiiskila
Surveyor's Michigan License No.: 33981

Date: 11-8-00

