

LAND CORNER RECORDATION CERTIFICATE

Filing Requirement of Act 74, Mich. PA 1970

For Corners In:
Charlevoix
 (County)

	Located In		Corner Code #
1. Public Land Survey	T _____	R _____	_____
	T _____	R _____	_____
2. Property Controlling in Section	S <u>27</u>	T <u>T33N</u>	R <u>4W</u>
	S <u>27</u>	T <u>T33N</u>	R <u>4W</u>
3. Miscellaneous Property in Section	S _____	T _____	R _____
	S _____	T _____	R _____


Register of Deeds Stamp & File Number

4. Lot No: _____ Recorded Plat: _____

5. Private Claims: _____

I, Carl T. Kiiskila, in a field survey on August, 2000 do hereby state that under requirements of PA 74, Michigan PA of 1970, the corner points mentioned in lines 1 and 2 above were in conformance with regulations and rules therefore as required in the current manual of survey instructions of the United States Department of the Interior, Bureau of Land Management or by a decree of a Court of Law and/or that the corner points mentioned in lines 3, 4 and 5 above were in conformance with the rules of the Michigan Board of Land Surveyors or by a Decree of a Court of Law; established, re-established, monumented, recovered, found as expressed below:

NOTE: Not more than 2 corners, all in the same town and range, may be recorded on this certificate.

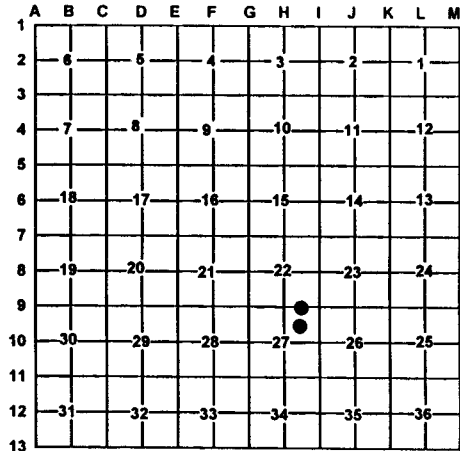

A. Description of original monument and accessories and/or subsequent restoration:

- 2-This corner position was not established during the original government survey.
- 6-This corner position was not established during the original government survey.

B. Description of corner evidence found and/or method applies in restoring or re-establishing corner:

- 2- Established the Northeast corner of the Northwest quarter of the Northeast quarter of section 27 by B.L.M. instructions for the subdivision of a section.
- 6- Established the Northwest corner of the Southeast quarter of the Northeast quarter of section 27 by B.L.M. instruction for subdivision of a section.

C. Description of monument for corner and accessories established to perpetuate locating the position of the corner:

- | | |
|--|--|
| 2- 1" X 32" pipe with P.S. cap #33981
Wit: 5" ironwood S23°E 7.86'
4" Twin Maple S58°W 37.28'
3" Maple N47°W 9.96'
5" Maple N81°E 13.18'
Carsonite post North 1'± | 6- 5/8" X32" Rerod with P.S. cap #33981 in a ring of stones.
Wit: 10" Beech N38°W 11.76'
14" Maple N77°E 39.25'
14" Maple S68°E 42.60'
4" Beech S51°W 12.70'
Carsonite post North 1'± |
|--|--|

Signed by: Carl T. Kiiskila
 Surveyor's Michigan License No.: 33981

Date: 11-8-00

