

LAND CORNER RECORDATION CERTIFICATE

Filing Requirement of Act 74, Mich. PA 1970

For Corners In:
Charlevoix Located In _____ Corner Code # _____
 (County)

1. Public Land Survey	T	<u>33N</u>	R	<u>4W</u>	C-2
	T	_____	R	_____	_____
2. Property Controlling in Section	S	_____	T	_____	_____
	S	_____	T	_____	_____
3. Miscellaneous Property in Section	S	_____	T	_____	_____
	S	_____	T	_____	_____


4. Lot No: _____ Recorded Plat: _____

5. Private Claims: _____

I, Carl T. Kiiskila, in a field survey on August 30, 2004 do hereby state that under requirements of PA 74, Michigan PA of 1970, the corner points mentioned in lines 1 and 2 above were in conformance with regulations and rules therefore as required in the current manual of survey instructions of the United States Department of the Interior, Bureau of Land Management or by a decree of a Court of Law and/or that the corner points mentioned in lines 3, 4 and 5 above were in conformance with the rules of the Michigan Board of Land Surveyors or by a Decree of a Court of Law; established, re-established, monumented, recovered, found as expressed below:

NOTE: Not more than 2 corners, all in the same town and range, may be recorded on this certificate.

Register of Deeds Stamp & File Number

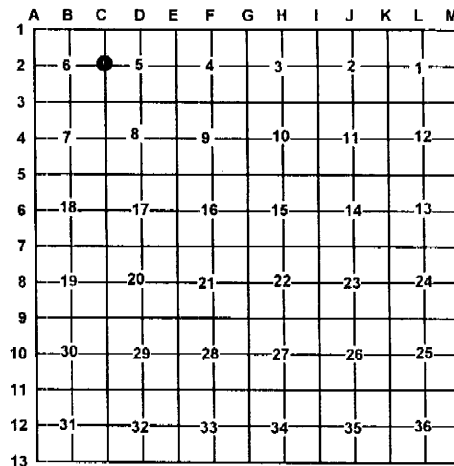

A. Description of original monument and accessories and/or subsequent restoration:

C-2 G.L.O. C.W. Cathcart 1841, used a Birch 10 inch for the quarter Section post.

Liber 2, Page 156, John E. Ferguson 1982 set 1/2" rod and cap on line between Southeast corner and Northeast corner at prorated G.L.O. distances.

County Surveyor E.A. Robinson 1894 book 32-A Page 147 found C.W. Cathcart's Birch 1/4 tree
 Wit: Hemlock 9" S45 3/4°W 32.5 links
 Balsam 5" N26 3/4°E 19 links

Wit: 6" Balsam	S15°W	10.75'
6" Balsam	S20°E	8.26'
12" Spruce	N80°E	17.03'
6" Balsam	N50°W	7.01'

B. Description of corner evidence found and/or method applies in restoring or re-establishing corner:

C-2 Found 1/2" iron rod w/ P.S. cap #24595 by John E. Ferguson. This iron rod falls online between C-1 and C-3 2638.18 feet North of C-3. E.A. Robinson 1894 distance is recorded as 2642.6 feet.

C. Description of monument for corner and accessories established to perpetuate locating the position of the corner:

C-2 Set 1" X 48" iron pipe with standard Department of Natural Resources aluminum cap over top of found 1/2" capped iron rod.

Wit: 6" Spruce	S81°W	23.56'
6" Spruce	S26°E	28.31'
4" Balsam	N55°W	26.44'
3" Balsam	N29°E	8.74'
Blue Carsonite Post	North	1±



Signed by: Carl T. Kiiskila

Date: 12-2-04

Surveyor's Michigan License No.: 33981