

**LAND CORNER RECORDATION CERTIFICATE**  
**Filing Requirement of Act 74, Mich. P.A. 1970**

For corners in

|                                       |                          |               |
|---------------------------------------|--------------------------|---------------|
| <u>Charlevoix</u><br>(County)         | Located In:              | Corner Code # |
| 1. Public Land Survey                 | T <u>33N</u> R <u>5W</u> | <u>H-10</u>   |
|                                       | T <u>33N</u> R <u>5W</u> | <u>J-12</u>   |
| 2. Property Controlling<br>in Section | S _____ T _____ R _____  | _____         |
|                                       | S _____ T _____ R _____  | _____         |
| 3. Miscellaneous<br>Property in Sec.  | S _____ T _____ R _____  | _____         |
|                                       | S _____ T _____ R _____  | _____         |

**Register of Deeds Stamp & File Num**

4. Lot No. \_\_\_\_\_, Recorded Plat \_\_\_\_\_

5. Private Claims \_\_\_\_\_

I, Carl T. Kiiskila, in a field survey on June 14, 19 99 do hereby state that under requirements of P.A. 74, Michigan P.A. of 1970, the corner points mentioned in lines 1 and 2 above were in conformance with regulations and rules therefore as required in the current manual of survey instructions of the United States Department of the Interior, Bureau of Land Management or by a decree of a Court of Law and /or that the corner points mentioned in lines 3, 4 and 5 above were in conformance with the rules of the Michigan Board of Land Surveyors or by a Decree of a Court of Law; established, re-established, monumented, recovered, found as expressed below:

|    |   |    |   |    |   |   |    |   |    |   |    |   |    |
|----|---|----|---|----|---|---|----|---|----|---|----|---|----|
|    | A | B  | C | D  | E | F | G  | H | I  | J | K  | L | M  |
| 1  |   |    |   |    |   |   |    |   |    |   |    |   |    |
| 2  |   | 6  |   | 5  |   |   | 4  |   | 3  |   | 2  |   | 1  |
| 3  |   |    |   |    |   |   |    |   |    |   |    |   |    |
| 4  |   | 7  |   | 8  |   |   | 9  |   | 10 |   | 11 |   | 12 |
| 5  |   |    |   |    |   |   |    |   |    |   |    |   |    |
| 6  |   | 18 |   | 17 |   |   | 16 |   | 15 |   | 14 |   | 13 |
| 7  |   |    |   |    |   |   |    |   |    |   |    |   |    |
| 8  |   | 19 |   | 20 |   |   | 21 |   | 22 |   | 23 |   | 24 |
| 9  |   |    |   |    |   |   |    |   |    |   |    |   |    |
| 10 |   | 30 |   | 29 |   |   | 28 |   | 27 |   | 26 |   | 25 |
| 11 |   |    |   |    |   |   |    |   |    |   |    |   |    |
| 12 |   | 31 |   | 32 |   |   | 33 |   | 34 |   | 35 |   | 36 |
| 13 |   |    |   |    |   |   |    |   |    |   |    |   |    |

**NOTE:** Not more than 2 corners, all in the same town and range, may be recorded on this certificate.

**A. Description of original monument and accessories and/or subsequent restoration:**

|  |  |
|--|--|
| H-10 This corner position was not established during the original government survey. | J-12 This corner position was not established during the original government survey. |
|--|--|

**B. Description of corner evidence found and/or method applied in restoring or reestablishing corner:**


|   |   |
|---|---|
| H-10 Established the center of Section 27 at the intersection of the north-south and east-west one quarter lines per standard B.L.M. instructions for the subdivision of a section. | J-12 Established the center of Section 35 at the intersection of the north-south and east-west one quarter lines per standard B.L.M. instructions for the subdivision of a section. |
|---|---|

**C. Description of monument for corner and accessories established to perpetuate locating the position of the corner:**

|  |   |
|--|---|
| H-10 Set 5/8" x 32" rerod with PS cap and carsonite marker post. | J-12 Set standard DNR monument and carsonite marker post. |
| Wit: Set nail in 20" Cherry N 26° W 97.51'                       | Wit: Set nail in 8" Ash S 85° W 19.47'                    |
| Set nail in 14" & 18" twin Apple S 22° E 190.80'                 | Set nail in 3" Ash N 28° W 11.86'                         |
| Set nail in 24" Basswood S 88° E 142.04'                         | Set nail in 6"-10" Cedar clump N 72° E 31.03'             |
| Set nail in 40" Maple clump N 64° E 152.29'                      | Fence corner post   |
| Carsonite post North 1'  | wire south & east S 76° W 23.5'                           |
|  | East-west fence South 6'                                  |
|  | Carsonite post North 1'                                   |

Signed by Carl T. Kiiskila

Surveyor's Michigan License No. 33981

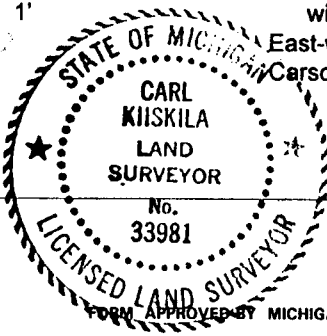

Date 7-26-99