

LAND CORNER RECORDATION CERTIFICATE
Filing Requirement of Act 74, Mich. P.A. 1970

For corners in

<u>Charlevoix</u> (County)	Located In:	Corner Code #
1. Public Land Survey	T _____ R _____ T _____ R _____	_____
2. Property Controlling in Section	S <u>35</u> T <u>33N</u> R <u>5W</u>	<u>15</u>
3. Miscellaneous Property in Sec.	S _____ T _____ R _____ S _____ T _____ R _____	_____

Register of Deeds Stamp & File Num

4. Lot No. _____, Recorded Plat _____

5. Private Claims _____

I, Carl T. Kiiskila, in a field survey on June 14, 19 99 do hereby state that under requirements of P.A. 74, Michigan P.A. of 1970, the corner points mentioned in lines 1 and 2 above were in conformance with regulations and rules therefore as required in the current manual of survey instructions of the United States Department of the Interior, Bureau of Land Management or by a decree of a Court of Law and /or that the corner points mentioned in lines 3, 4 and 5 above were in conformance with the rules of the Michigan Board of Land Surveyors or by a Decree of a Court of Law; established, re-established, monumented, recovered, found as expressed below:

	A	B	C	D	E	F	G	H	I	J	K	L	M
1													
2	6			5		4		3		2		1	
3													
4	7			8		9		10		11		12	
5													
6	18			17		16		15		14		13	
7													
8	19			20		21		22		23		24	
9													
10	30			29		28		27		26		25	
11													
12	31			32		33		34		35		36	
13													

NOTE: Not more than 2 corners, all in the same town and range, may be recorded on this certificate.

A. Description of original monument and accessories and/or subsequent restoration:

15 - This corner position was not established during the original government survey.


B. Description of corner evidence found and/or method applied in restoring or reestablishing corner:

15 - Found and accepted a 1/2" iron rod with cap set by James L. Schwandt, LLS #26466.

C. Description of monument for corner and accessories established to perpetuate locating the position of the corner:

15 - 1/2" iron rod with LLS cap #26466.
 Set carsonite marker post.
 Wit: Set nail in 7" Ironwood West 9.39'
 Set nail in 2" Elm N 6° E 10.33'
 Set nail in 24" Maple N 66° E 22.55'
 Set nail in 6" Basswood S 34° W 18.81'
 Carsonite post North 1'

Signed by Carl T. Kiiskila
 Surveyor's Michigan License No. 33981

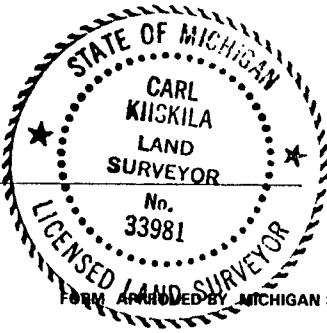

Date 7-26-99