

# LAND CORNER RECORDATION CERTIFICATE

Filing Requirement of Act 74, Mich. PA 1970

For Corners In:  
Charlevoix Located In \_\_\_\_\_ Corner Code # \_\_\_\_\_  
 (County)


- |                                      |   |           |            |            |           |           |
|--------------------------------------|---|-----------|------------|------------|-----------|-----------|
| 1. Public Land Survey                |   | T         | <u>33N</u> | R          | <u>5W</u> | J-1       |
|                                      |   | T         | _____      | R          | _____     | _____     |
| 2. Property Controlling in Section   | S | <u>11</u> | T          | <u>33N</u> | R         | <u>5W</u> |
|                                      | S | _____     | T          | _____      | R         | _____     |
| 3. Miscellaneous Property in Section | S | _____     | T          | _____      | R         | _____     |
|                                      | S | _____     | T          | _____      | R         | _____     |

4. Lot No: \_\_\_\_\_ Recorded Plat: \_\_\_\_\_  
 5. Private Claims: \_\_\_\_\_

I, Carl T. Kiiskila, in a field survey on July 24, 2002 do hereby state that under requirements of PA 74, Michigan PA of 1970, the corner points mentioned in lines 1 and 2 above were in conformance with regulations and rules therefore as required in the current manual of survey instructions of the United States Department of the Interior, Bureau of Land Management or by a decree of a Court of Law and/or that the corner points mentioned in lines 3, 4 and 5 above were in conformance with the rules of the Michigan Board of Land Surveyors or by a Decree of a Court of Law; established, re-established, monumented, recovered, found as expressed below:

**NOTE: Not more than 2 corners, all in the same town and range, may be recorded on this certificate.**

Register of Deeds Stamp & File Number

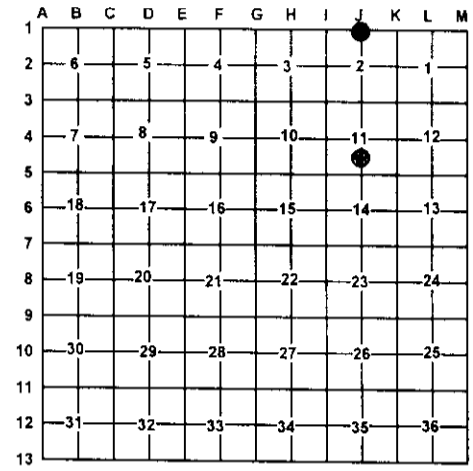

**A. Description of original monument and accessories and/or subsequent restoration:**

- |   |   |
|---|---|
| J-1 The North quarter corner of section 2 was not set during the original survey.   | 12- This corner position was not established during the original government survey. |
| E.K. Robinson's county survey records, 1894 sketch of section 2 found in book 32A shows he had a position calculated for this position. No witnesses or type of monument was given. |   |

**B. Description of corner evidence found and/or method applies in restoring or re-establishing corner:**

- |   |  |
|---|--|
| J-1 Set a 5/8" X 32" rerod w/ P.S. cap #33981 4.95' (7.5 links) East of J-13 T.34N., R.5W. per E.K. Robinsons 1894 sketch of section 2. | 12- Established the Northwest corner of the Southwest quarter of the Southeast quarter of section 11 per B.L.M. instructions for subdivision of a section. |
|---|--|

**C. Description of monument for corner and accessories established to perpetuate locating the position of the corner:**

- |   |   |
|---|---|
| J-1 Set a 5/8" X 32" rerod with P.S. cap #33981<br>Wit: 8" Cedar N47°W 48.92'<br>12" Cedar N01°W 28.65'<br>8" Cedar S04°W 37.55'<br>7" White Pine S62°W 38.78'<br>5/8" X 32" rerod w/P.S. cap #33981<br>S ¼ cor. sec. 35 T.34N., R.5W. N84°W 4.95'<br>Rod falls in the Center line of Bear River Road | 12- Set 1" X 48" pipe with P.S. cap #33981<br>Wit: 7" Cedar N67°E 23.25'<br>9" Cedar N72°E 16.74'<br>11" Cedar N55°W 15.79'<br>12" W. Pine S08°W 28.14' |
|---|---|

Signed by: Carl T Kiiskila  
 Surveyor's Michigan License No.: 33981

Date: 12-19-02

