

**SURVEY &
REMONUMENTATION**

JAN 26 1998

SECTION

**LAND CORNER RECORDATION CERTIFICATE
Filing Requirement of Act 74, Mich. P.A. 1970**

STATE OF MICHIGAN
COUNTY OF CHARLEVOIX
RECEIVED FOR RECORD

97 DEC 16 AM 10:14

Charlotte M. Coburn
REGISTER OF DEEDS

For corners in

<u>CHARLEVOIX</u> (County)	Located In:	Corner Code #
1. Public Land Survey	T <u>33NR 6W</u>	<u>D-13</u>
	T <u> </u> R <u> </u>	<u> </u>
	T <u> </u> R <u> </u>	<u> </u>
	T <u> </u> R <u> </u>	<u> </u>
2. Property Controlling in Section	S <u> </u> T <u> </u> R <u> </u>	<u> </u>
	S <u> </u> T <u> </u> R <u> </u>	<u> </u>
3. Miscellaneous Property in Sec.	S <u> </u> T <u> </u> R <u> </u>	<u> </u>
	S <u> </u> T <u> </u> R <u> </u>	<u> </u>

Register of Deeds Stamp & File Number

4. Lot No. _____, Recorded Plat _____
5. Private Claims _____

I, ARTHUR R. RANGER, in a field survey on SEPT. 15, 1997
do hereby state that under requirements of P.A. 74, Michigan P.A. of 1970, the corner points mentioned in lines 1 and 2 above were in conformance with regulations and rules therefore as required in the current manual of survey instructions of the United States Department of the Interior, Bureau of Land Management or by a decree of a Court of Law and /or that the corner points mentioned in lines 3, 4 and 5 above were in conformance with the rules of the Michigan Board of Land Surveyors or by a Decree of a Court of Law; established, re-established, monumented, recovered, found as expressed below:

NOTE: Not more than 2 corners, all in the same town and range, may be recorded on this certificate.

	A	B	C	D	E	F	G	H	I	J	K	L	M
1													
2		6		5		4		3		2		1	
3													
4		7		8		9		10		11		12	
5													
6		18		17		16		15		14		13	
7													
8		19		20		21		22		23		24	
9													
10		30		29		28		27		26		25	
11													
12		31		32		33		34		35		36	
13													

A. Description of original monument and accessories and/or subsequent restoration:
D-13 S. 1/4 corner Sec. 32, T.33N., R.6W.
 1840-John Hodgson set a 1/4 Sec. Post and witnessed: Beech 7" N27°W 9lks.; Beech 7" N5°E 27 lks.
 1881-E.K. Robinson used the corner in his survey of Sec. 32, T.33N., R.6W.
 1895-E.K. Robinson found the corner in his survey along the North line of Sec. 5, T.32N., R.6W.
 1973-Charlevoix Abstract old notes along the Townline--the corner not found at that time.
 1994-John Ferguson found a 1/2" rod and used in his survey in Sec. 5, T.32N., R.6W. witnesses: 60" Pop. N50°E 49.30'; 30" Pop. N30°W 34.55'; 24" Pop. S30°E 29.09'
 1995-John Ferguson found a 1/2" rod and used in his survey in Sec. 32, T.33N., R.6W.--witnesses: same as above.


B. Description of corner evidence found and/or method applied in restoring or reestablishing corner:
D-13 South 1/4 corner of Sec. 32, T.33N., R.6W.
 1997-Arthur R. Ranger found the 1/2" rod and witnesses of record; The corner line^s up with a very old fence line to the North;
 The corner compares quite well with old Robinson distances to the East and West.

C. Description of monument for corner and accessories established to perpetuate locating the position of the corner:
D-13 South 1/4 corner of Sec. 32, T.33N., R.6W.
 (Set a Charlevoix County Monument)
 20" Cottonwood N22°W 35.00'
 48" Cottonwood N64°E 50.12'
 18" Cottonwood S26°E 29.83'
 9" Pop. S28°W 38.00'
 1/2" rod North 33.00'

Charlevoix Co. Surveyor
 APPROVED
 Signature Mary C. Fennell
 Date: 12.6.11-97

AND IS ACCEPTED AS A CAREFUL AND FAITHFUL PERPETUATION OF THE POSITION OF THE ORIGINAL CORNER.

Signed by Arthur R. Ranger Date 12/06/97
 Surveyor's Michigan License No. 31601

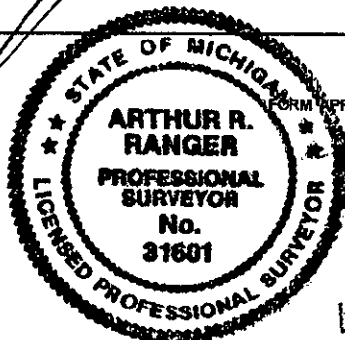

FORM APPROVED BY MICHIGAN STATE BOARD OF PROFESSIONAL SURVEYORS, JAN. 28, 1971
 REVISED MAY 14, 1975
 REVISED JAN., 1983
 REVISED OCT., 1995