

NOV 2 1 1997

COMMISSION

LAND CORNER RECORDATION CERTIFICATE
Filing Requirement of Act 74, Mich. P.A. 1970

STATE OF MICHIGAN
COUNTY OF CHARLEVOIX
RECEIVED FOR RECORD

97 OCT 31 PH 3:11

Charles M. Embler
REGISTER OF DEEDS

For corners in

CHARLEVOIX (County)	Located In:	Corner Code #
1. Public Land Survey	T 33NR 6W	L-13
	T ___ R ___	_____
	T ___ R ___	_____
	T ___ R ___	_____
2. Property Controlling In Section	S ___ T ___ R ___	_____
	S ___ T ___ R ___	_____
3. Miscellaneous Property in Sec.	S ___ T ___ R ___	_____
	S ___ T ___ R ___	_____

Register of Deeds Stamp & File Number

4. Lot No. _____, Recorded Plat _____
5. Private Claims _____

I, ARTHUR R. RANGER, in a field survey on JUNE 07, 1997
do hereby state that under requirements of P.A. 74, Michigan P.A. of 1970, the corner points mentioned in
lines 1 and 2 above were in conformance with regulations and rules therefore as required in the current manual
of survey instructions of the United States Department of the Interior, Bureau of Land Management or by a
decree of a Court of Law and for that the corner points mentioned in lines 3, 4 and 5 above were in
conformance with the rules of the Michigan Board of Land Surveyors or by a Decree of a Court of Law;
established, re-established, monumented, recovered, found as expressed below:

NOTE: Not more than 2 corners, all in the same town and range, may be recorded
on this certificate.

	A	B	C	D	E	F	G	H	I	J	K	L	M
1													
2		6		5		4		3		2		1	
3													
4		7		8		9		10		11		12	
5													
6		18		17		16		15		14		13	
7													
8		19		20		21		22		23		24	
9													
10		30		29		28		27		26		25	
11													
12		31		32		33		34		35		36	
13													

A. Description of original monument and accessories and/or subsequent restoration:

L-1 1/4 corner common to Sec. 1, T.32N., R.6W. & Sec. 36, T.33N., R.6W.

1839-John Hodgson set a 1/4 Sec. Post and witnessed; Beech 12" N63°E 10lks; Hemlock 14"
N42°W 18lks.

18__ E.K. Robinson notes referencing the corner and the new witnesses; Sugar 14" N54°E 56lks; Beech 8" N56°W 60lks.

1889-E.A. Robinson notes in a Sec. 36, T.33N., R.6W. Survey.

1993-Ted _____ used the corner in a survey and replaced the old 2" I.P. with an unknown stake type, and witnessed; 12" Maple N51°E 100.5';
20" Elm S74°E 155.7'; 28" maple N26°W 28.7'; S.W. Hse. Corner N44°W 146.4'; Recorded in L.C.R.C. liber 01, Pg. 149.

1972-Mary C. Feindt references the corner in a survey of a part of Sec. 1, T.32N., R.6W.; Rec. in liber 225, Pg. 634.

1973-Mary C. Feindt references the corner again in a survey of a part of Sec. 1, T.32N., R.6W.; Rec. in liber 228, Pg. 887.

1975-Carl F. Roser found and accepted a Charlevoix County monument; fits survey by Williams & Works to East for 1/2 mile; Witnessed:
P.P. N88°W 17.14'; 36" Maple N25°W 28.54'; cl M-75 Due S. 40'; Recorded in L.C.R.C. 02, Pg. 20.

1975-Mary C. Feindt references the corner in a survey in Sec. 1, T.32N., R.6W., recorded in liber 229, pg. 667.

1981-John Nelson found a monument at the corner in his survey; recorded in liber 268, pg. 698

1982-John Nelson found concrete monument w/DNR 4" post and tag 38.20' North of the cl of M-75. Corner previously used by Mary C. Feindt in a
Survey dated June 4, 1975 and Oct. 4, 1978; Witnesses: 4" Poplar Az. 54°; 24" Maple Az. 177° 101.28'; P.P. Az. 263° 9.72'; 36" Maple Az.
335° 29.22'; recorded in L.C.R.C. 02, Pg. 151.

198__ Beryl M. Jones used the corner in a survey; Recorded in liber 313, pg. 240.

1983-Beryl M. Jones used the corner in a survey; Recorded in liber 312, pg. 79; The survey was in Sec. 36, T.33N., R.6W.; He found a conc. Mon.
And witnessed: P.P. N89°W 16.75'; 22" Maple S. 101.40'; 12" Spruce N60°W 128.70'; 15" Maple N30°W 122.60'

1985- James L. Schwandt used the corner in a survey in Sec. 36, T.33N., R.6W.; He found a Charlevoix County Monument and witnessed:

P.P. N88°W 17.14'; 36" Maple N25°W 28.54'; 49" Cottonwood N24°E 27.63'; cl M-75 S. 40'; recorded in liber 291, pg. 958

1985- John Ferguson used the corner in a survey in Sec. 36, T.33N., R.6W.; He found a Charlevoix County Monument and witnessed:

P.P. N89°20'54" W 16.75'; 36" Maple N28°56'33" W 28.89'; 49" cottonwood N23°38'W 27.63'; Recorded in liber 291, pg. 959.

1986- Phil Wetoskey found the conc. Monument, and used in a survey and witnessed; spike S89°34'36"W 7.53'; P.P. S86°W 9.65'; 54" Poplar

N25°E 28.63'; 33" Maple N25°W 30.30'; 20" Tri. Spruce N38°W 93.95'; S.W. bolt in conc. Lt base N10°E 75.77'; L.C.R.C. recorded in

002, Pg. 212; The survey was in Sec. 36, T.33N., R.6W.

1989- Beryl Jones found the conc. Monument and used in a survey, and witnessed; P.P. N89°W 16.75'; 22" Maple S. 101.40'; 12" Spruce

N60°W 128.70'; 15" Maple N30°W 122.60', Recorded in liber 317, Pg. 93; The survey was in Sec. 36, T.33N., R.6W.

1989- Beryl Jones used the corner in a survey dated 08/08/89, and recorded in liber 321, Pg. 54; The survey was in Sec. 36, T.33N., R.6W.

1989- Beryl Jones used the corner in a survey in Sec. 36, T.33N., R.6W., and recorded in liber 324, Pg. 183.

B. Description of corner evidence found and/or method applied in restoring or reestablishing corner:

L-1 1/4 corner common to Sec. 1, T.32N., R.6W. & Sec. 36, T.33N., R.6W.

1997- Arthur R. Ranger found the Charlevoix County Monument, and witnesses cl record; The corner fits surveys and existing monumentation in the area.

C. Description of monument for corner and accessories established to perpetuate locating the position of the corner:

L-1 1/4 corner common to Sec. 1, T.32N., R.6W. & Sec. 36, T.33N., R.6W.

(Found a Charlevoix County Monument)

P.P. WEST 9.64'


MANHOLE NORTH 22.3'

MAPLE 14" N24°W 122.50'

S.W. BOLT ON LT. POLE N08°E 75.83'

Charlevoix Co. Surveyor
APPROVED

Signature Mary C. Feindt
Date: Sept 10, 1997

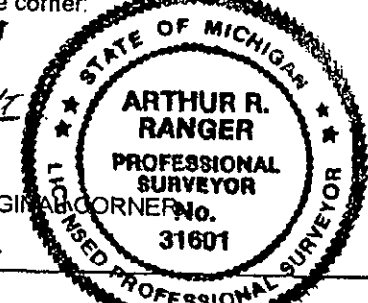

AND IS ACCEPTED AS A CAREFUL AND FAITHFUL PERPETUATION OF THE POSITION OF THE ORIGINAL CORNER

Signed by Arthur R. Ranger

Date Sept. 10, 1997

Surveyor's Michigan License No. 31601