

STATE OF MICHIGAN
COUNTY OF CHARLEVOIX
REGISTER OF DEEDS

96 DEC 11 PM 3:02

LAND CORNER RECORDATION CERTIFICATE
Filing Requirement of Act 74, Mich. P.A. 1970

Wayne E. Doss
REGISTER OF DEEDS

SURVEY &
REMONUMENTATION

FEB 19 1998

Register of Deeds Stamp & File Number


SECTION

or corners in Charlevoix (County)	Located in:	Corner Code #
Public Land Survey	T 32N R 7W T 33N R 7W R T T R	D-1 D-13
Property Controlling in Section	S T R	
Miscellaneous Property in Sec.	S T R	

Lot No. _____, Recorded Plat _____
Private Claims _____

Wayne E. Doss in a field survey on OCTOBER 18 19 96
I hereby certify that under requirements of P.A. 74, Michigan P.A. of 1970, the corner points mentioned
in lines 1 and 2 above were in conformance with regulations and rules therefore as required in the
current manual of survey instructions of the United States Department of the Interior, Bureau of Land
Management or by a decree of a Court of Law and/or that the corner points mentioned in lines 3, 4 and 5
above were in conformance with the rules of the Michigan Board of Land Surveyors or by a Decree of a
Court of Law; established, re-established, monumented, re-monumented, recovered, found as
expressed below:

NOTE: Not more than 4 corners, all in the same town and range, may be recorded
on this certificate.

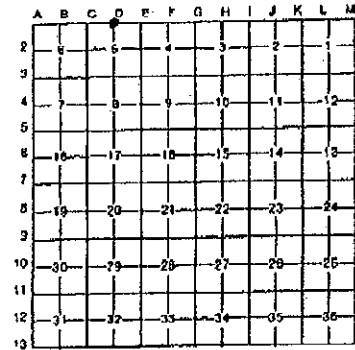

Description of original monument and accessories and/or subsequent restoration:

- | | | | |
|-----|---|---|--|
| D-1 | QLO JUNE 1939
JOHN HODGSON
SET ¼ SECT. POST
1. BEECH 7 N59W 17
2. BEECH 7 W11E 23 | NO TIMBER FOR BEARING TREES.
3. SCHOOL HOUSE S46E 129

E.K. ROBINSON MAY 1895 SET ¼
POST MIDWAY BETWEEN C-1 &
E-1 T32N-R7W
4. APPLE TREE 4 N56W 53 ½
5. CHERRY TREE 4 N57½E 56 ½ | ½" IR. SET BY UNKNOWN. J. FERGUSON
WITNESSED COR. IN MAY 1994
6. FENCE POST NORTH 1.25'
7. FENCE POST WEST 0.85'
8. 12" BASSWOOD S80E 19.54'
9. 7" POPLAR S32W 65.00' |
| | W. MILLER AUG. 1883
SET ¼ POST MIDWAY
BETWEEN SEC. CORNERS | | |

Description of corner evidence found and/or method applied in restoring or reestablishing corner:


- D-1 FOUND ½" IRON
7. FENCE POST NORTH 1.25'
8. FENCE POST WEST 0.85'
9. 12" BASSWOOD S80E 19.54'
10. 7" POPLAR S32W 65.00'

Charlevoix Co. Surveyor
APPROVED
Signature Wayne E. Doss
Date: DEC 19 1996

Description of monument for corner and accessories established to perpetuate locating the position of the corner:

- D-1 & D-13 D-1 T32N-R7W CORNER COMMON TO D-13 T33N-R7W
CHARLEVOIX CO. MON. SET
7. FENCE POST NORTH 1.25'
8. FENCE POST WEST 0.85'
9. 12" BASSWOOD S80E 19.54'
10. 7" POPLAR S32W 65.00'

AND IS ACCEPTED AS A CAREFUL AND FAITHFUL REESTABLISHMENT OF THE ORIGINAL CORNER

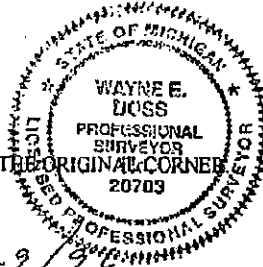

Recorded by Wayne E. Doss Date 11/29/96
Surveyor's Michigan License No. 20703 LIBER 003 PAGE 11