

FEB 19 1998

STATE OF MICHIGAN
COUNTY OF CHARLEVOIX
REGISTER OF DEEDS

96 DEC 11 PM 3:09

SECTION

LAND CORNER RECORDATION CERTIFICATE
Filing Requirement of Act 74, Mich. P.A. 1970

Charles M. ...
REGISTER OF DEEDS

corners in
Charlevoix
County

Located in: Corner Code #

Public Land Survey


T 32N	R 7W	K-1
T 33N	R 7W	K-13
T	R	
T	R	

Property Controlling
in Section
Miscellaneous
Property in Sec.

S	T	R
S	T	R
S	T	R
S	T	R

Register of Deeds Stamp & File Number

Lot No. _____ Recorded Plat _____
Private Claims _____

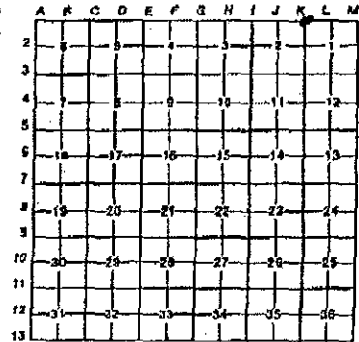

Wayne E. Boss, in a field survey on OCTOBER 14, 19 96, hereby certify that under requirements of P.A. 74, Michigan P.A. of 1970, the corner points mentioned in lines 1 and 2 above were in conformance with regulations and rules therefore as required in the current manual of survey instructions of the United States Department of the Interior, Bureau of Land Management or by a Decree of a Court of Law and/or that the corner points mentioned in lines 3, 4 and 5 above were in conformance with the rules of the Michigan Board of Land Surveyors or by a Decree of a Court of Law: established, re-established, monumented, re-monumented, recovered, found as pressed below:

DTE: Not more than 4 corners, all in the same town and range, may be recorded on this certificate.

Description of original monument and accessories and/or subsequent restoration:

- | | | |
|-----|--|---|
| K-1 | GLO JUNE 1839
JOHN HODGSON
SECT. COR. POST.
1. BEECH 24 N51E 6
2. SUGAR 12 N66W 31 | 1" IR. BAR SET BY UNKNOWN
USED & WITNESSED BY
LAWRENCE FEINDT IN 1978
3. NORTH 14.45° 30" MAPLE
4. S10E 20.25° 16" MAPLE
5. S40E 26.55° 6" MAPLE |
|-----|--|---|


Description of corner evidence found and/or method applied in restoring or reestablishing corner:

- K-1 FD. 1" BAR IN CTR. OF RD. NO TIE TO GLO
3. NORTH 14.45° 36" MAPLE
4. S10E 20.25° 22" MAPLE
5. S40E 26.55° 8" MAPLE

Charlevoix Co. Surveyor
APPROVED
Signature *Mary C. Ferrell*
Date: Dec. 13, 1996

Description of monument for corner and accessories established to perpetuate locating the position of the corner:

- K-1 & K-13 K-1 T32N-R7W COMMON CORNER TO K-13 T33N-R7W
CHARLEVOIX CO. MON. SET
3. NORTH 14.58° 36" MAPLE NEW SPIKE & TAG SET
4. S10E 19.02° 22" MAPLE NEW SPIKE & TAG SET IN ROOT
5. S40E 27.17° 8" MAPLE NEW SPIKE & TAG SET
6. N60W 38.11° 8" MAPLE NEW SPIKE & TAG SET

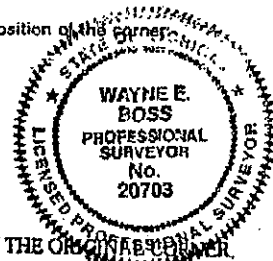

and by *Wayne E. Boss* Date 11/29/96
Surveyor's Michigan License No. 20703 LIBER 003 PAGE 83