


MEANDER CORNER DESIGNATION FOR  
 REMONUMENTATION PROGRAM  
 COMPUTERIZED INDEX SYSTEM

Town 33 North Range 7 West

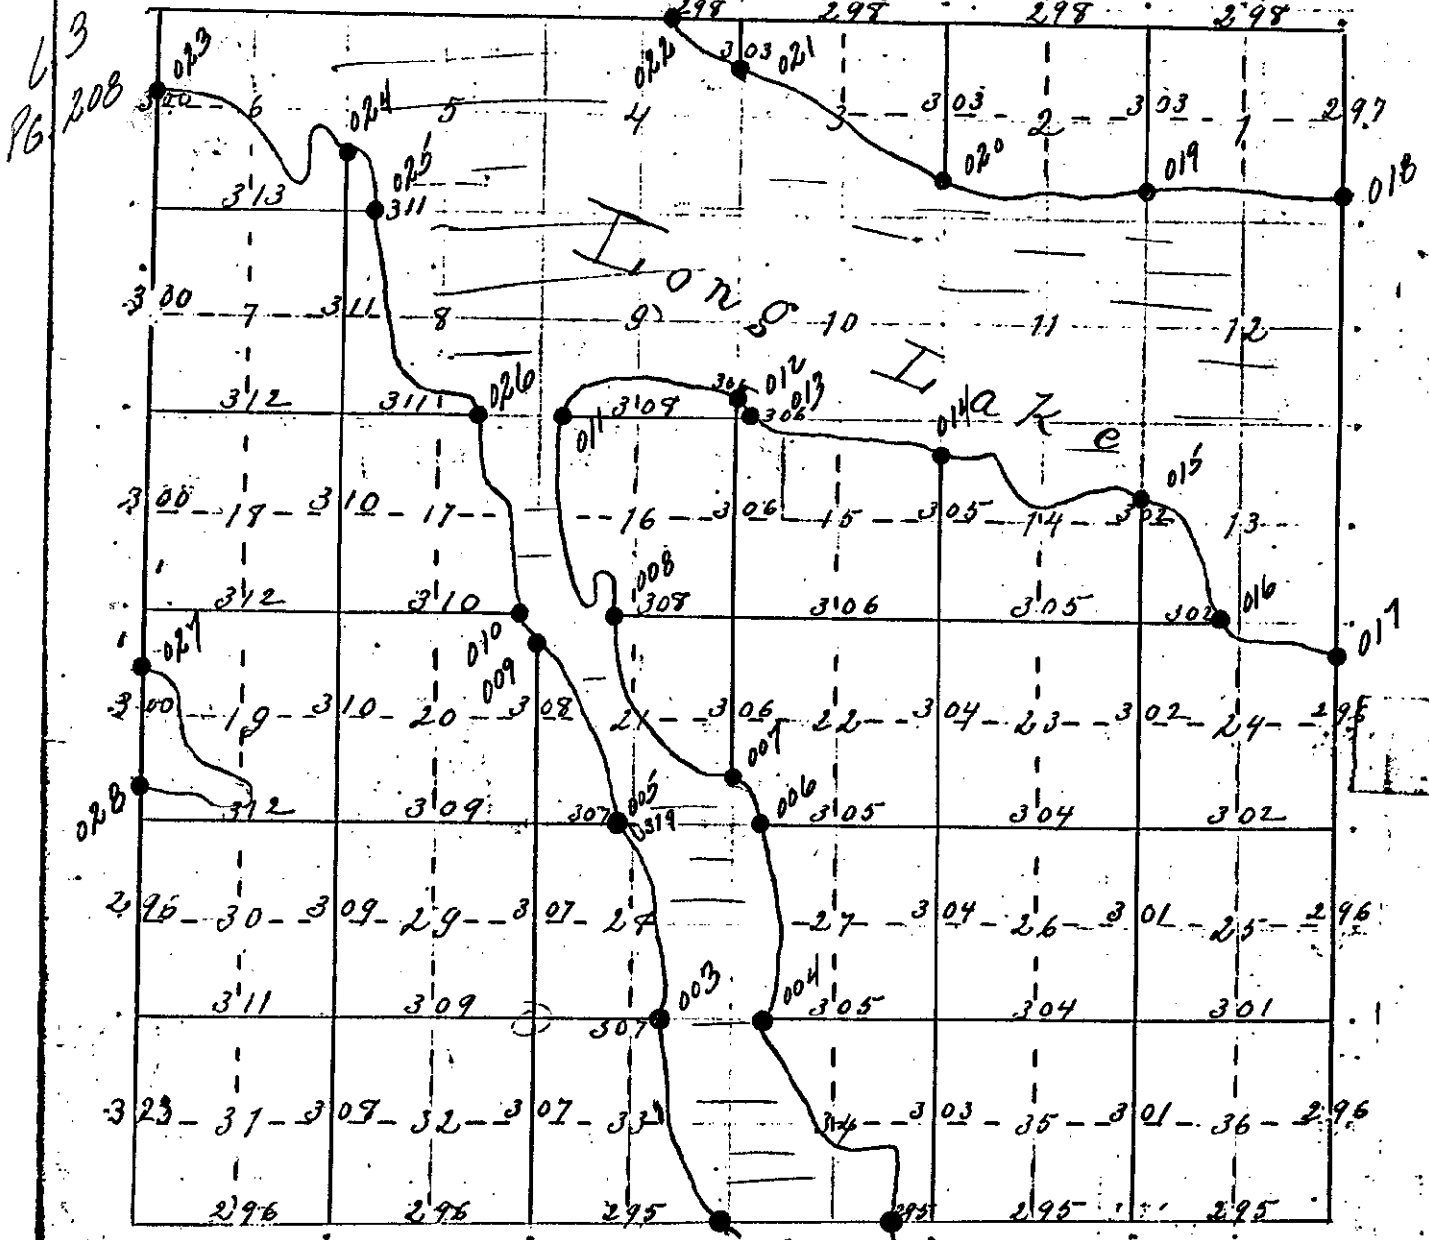

Meander Lines on Pages 313 to 319 2m

SURVEY &  
 REMONUMENTATION

FEB 04 1999

SECTION

66  
 10  
 54  
 529  
 66  
 54  
 125

EVELINE TWP.  
 Charlevoix County