

✓
MICHIGAN
DEPARTMENT OF CONSERVATION
FORESTRY DIVISION

LAND CORNER RECORD

T. 33 N.R. 8 W


Charlevoix COUNTY

DESCRIPTION OF CORNER 1/4 corner common to Sections 11 & 12

CORNER MONUMENT Set 1" x 3/8" pipe with brass cap.

DATE MONUMENT PLACED AND WITNESSED 12/7/67

WITNESSES TO CORNER.....

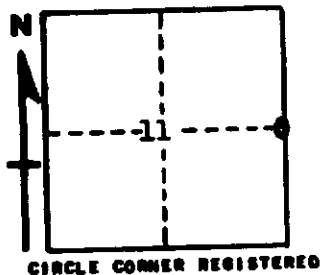

6" Cedar	S 20 E	12.8'
6" Cedar	S 65 W	15.2'
6" Cedar	N 35 W	11.4'

AND

DESCRIPTION IN DETAIL AS TO HOW CORNER WAS LOCATED AND IDENTIFIED OR RESTORED.

Found fence corner - fence S & W and pt. of old wood Stk.

SURVEYOR'S SEAL

SIGNED Gregory A. Shadko DATE 12/12/67
GREGORY A. SHADKO
REGISTERED LAND SURVEYOR # 1934