

✓

MICHIGAN
DEPARTMENT OF CONSERVATION
FORESTRY DIVISION

LAND CORNER RECORD

T. 33 N.R. 7 W
T. 33 N.R. 8 W


Charlevoix COUNTY

DESCRIPTION OF CORNER Section corner common to Sections 24, 25, 19 & 30

CORNER MONUMENT Set 1" x 36" Pipe with brass cap 12" above ground

DATE MONUMENT PLACED AND WITNESSED 12/4/67

WITNESSES TO CORNER.....

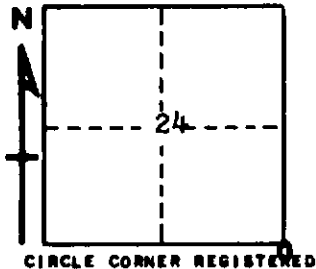

10" Maple	N 41°00' W	20.45'
8" Maple	S 47°30' E	22.50'
8" Maple	S 42°30' W	7.75'

AND

DESCRIPTION IN DETAIL AS TO HOW CORNER WAS LOCATED AND IDENTIFIED OR RESTORED.

Found fence corner. Fence N-W & E & South. Old road grade west and south.

SURVEYOR'S SEAL

Gregory A. Shadko
SIGNED GRZGORY A. SHADKO DATE 12/12/67
REGISTERED LAND SURVEYOR ~~10068~~

1934