

99 SEP 16 PH 2:26

LAND CORNER RECORDATION CERTIFICATE
 Filing Requirement of Act 74, Mich. P.A. 1970

Cherone B. Jentz
 REGISTER OF DEEDS

For corners in
Charlevoix
 (County)

Located In: Corner Code #

1. Public Land Survey

T 33N R 8W D-13 ✓
 T R
 T 32N R 8W D-1
 T R

2. Property Controlling
 In Section

S T R
 S T R

3. Miscellaneous
 Property in Sec.

S T R
 S T R

RE
 FEB 11 2000

SECTION
 Register of Deeds Stamp & File Number

4. Lot No. _____, Recorded Plat _____
 5. Private Claims _____

Wayne E. Boss APRIL 99

in a field survey on _____, 19____ do hereby state that under
 requirements of P.A. 74, Michigan P.A. of 1970, the corner points mentioned in lines 1 and 2 above were in
 conformance with regulations and rules therefore as required in the current manual of survey instructions of the
 United States Department of the Interior, Bureau of Land Management or by a decree of a Court of Law and/or
 that the corner points mentioned in lines 3, 4 and 5 above were in conformance with the rules of the Michigan
 Board of Land Surveyors or by a Decree of a Court of Law, established, re-established, monumented,
 recovered, found as expressed below:

NOTE: Not more than 2 corners, all in the same town and range, may be recorded
 on this certificate.

	A	B	C	D	E	F	G	H	I	J	K	L	M
1													
2	6		5		4		3		2		1		
3													
4	7		8		9		10		11		12		
5													
6	18		17		16		15		14		13		
7													
8	19		20		21		22		23		24		
9													
10	30		29		28		27		26		25		
11													
12	31		32		33		34		35		36		
13													

1. Description of original monument and accessories and/or subsequent restoration:

D-13 JUNE 5, 1839 MARCH 1880 JULY 14, & AUGUST 15, 1972
 JOHN HODGSON, DEPUTY SURVEYOR JOS R DIXON, DEPUTY SURVEYOR C. EUGENE OSTLING, P.S.
 SET POST FD. GOVERNMENT POST PLACED 1/2" x 18" IRON
 BEECH 7 INCH N11*W 23 LINKS & WITNESSES BY SINGLE PRORATION
 BEECH 7 INCH N58*E 13 LINKS 14" BEECH N45*W 12.45'
 6" MAPLE S29*E 11.10'
 24" BEECH N71*E 24.8'

2. Description of corner evidence found and/or method applied in restoring or reestablishing corner:


D-13 APRIL 22, 1999
 FD. 1/2" IRON & CAP 12026
 14" BEECH N45*W 12.45'
 6" MAPLE S29*E 11.10'
 24" BEECH N71*E 24.8'
 FOUND REMAINS OF FENCE NORTH & SOUTH
 E-1 TO D-1 GLO 40 CHAINS (2640') MEASURES N87*19'05"W 2613.93'
 D-1 TO C-1 GLO 40 CHAINS (2640') MEASURES N87*15'48"W 2613.05'

Charlevoix Co. Surveyor
 APPROVED
 Signature *Mary C. French*
 Date: APR 19 1999

3. Description of monument for corner and accessories established to perpetuate locating the position of the corner:

D-13 PLACED CHARLEVOIX COUNTY STEEL MARKER
 14" BEECH N57*W 12.80' SET NAIL & TAG
 12" MAPLE S23*E 11.16' SET NAIL & TAG
 24" BEECH N81*E 24.44' SET NAIL & TAG
 12" MAPLE S76*W 18.10' SET NAIL & TAG

AND IS ACCEPTED AS A CAREFUL & FAITHFUL REESTABLISHMENT OF THE POSITION OF THE ORIGINAL CORNER

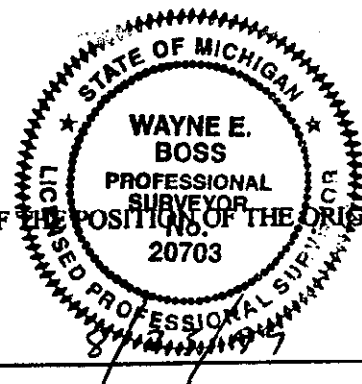

Signed by *Wayne E. Boss*
 Surveyor's Michigan License No. 20703

Date _____